


Section 10 Township 22 Range 11E

Well No. 2 Yearout

Company Cities Service

Greenwood County

NORTH

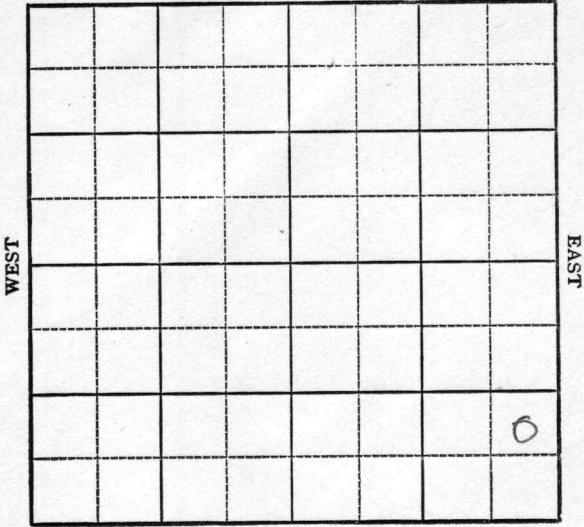

SOUTH

16

KANSAS

Greenwood ✓

Sec. 10 Twp. 22 R. 11-E

Well No. #2Yearout Farm _____

Cities Service Company _____
Miscellaneous


_____ Ft. from N. Line

990 Ft. from S. Line

330 Ft. from E. Line

_____ Ft. from W. Line

NE SE SE

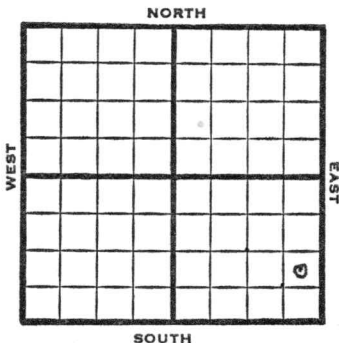

1948

Elev. -

REPORT

9/29

10" @ 57
Drlg 1052

10/6

Bart 1812'
TD 1983'

ABANDONED

Map No. _____ Sec. 10 Twp. 22 R. 11E

Well No. 2 Yearout

Cities Service _____ Company

FIRST REPORT _____ Contractor

NE SE SE

SECTION PLAT

_____ Ft. from N. Line

990 Ft. from S. Line

330 Ft. from E. Line

_____ Ft. from W. Line

			o

Greenwood County

Location _____

Rig up _____

Drilling and Remarks:

10" @ 57

drlg. 1052

RECORD

Cased _____ in., _____ ft.

Sand _____

Gas _____

Oil _____

Total Depth _____

PRODUCTION

1st 24 hrs. Nat. _____

1st 24 hrs. after shot _____

Gas _____ Cu. Ft.

Dry Hole _____

Abandoned _____

Date

SEP 29 1948

19

S. J. LEWIS

Scout

