

Harvey

KANSAS

SECTION 11 TOWNSHIP 22 RANGE 2 E

WELL NO. #1 Litton

COMPANY Tennessee Gas & Trans.

NORTH

				0			

WEST

EAST

SOUTH

Harvey

KANSAS

SEC.	TWP.	R.
11	22	2E

WELL NO.

#1 Litton

FARM

COMPANY

Tennessee Gas & Trans.

CONTRACTOR

Bedell & Catt

Wildcat


_____ Ft. from N. Line

_____ Ft. from S. Line

_____ Ft. from E. Line

_____ Ft. from W. Line

SW SW SE

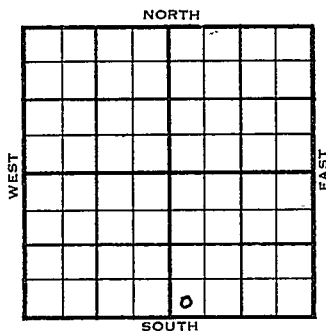

1955

ELEVATION

1407'

REPORT

11/16

Comm 11-13-55

8" @ 125/100

Drlg 640

11-30

DST 3039-43 op 1 hr. rec. 50' mud,
60' SW, 1085/15"

D & A

Tp. 1536

Dg. 1838

Doug Sd. 1868

L. 2087

M. 2758

Dolo 2845

K. 2908

Mz. 3040'

Hunton 3044

Maq. 3089

Viola 3115

Sd. 3173

A 3186

TD 3250'

ABANDONED

County Harvey Elev. _____
 Sec. 11 Twp. 22 Rge. 2E
 Company Tennessee Gas & Trans.
 Farm Name Litton No. 1

TOPS	DEPTH	LOG	DATUM
Anh.			
Tr.			
H.			
Tr.			
Dg.			
BL.			
L.			
K.C.			
B.K.C.			
Ce.			
C.			
M.			
M.			
K.			
Mz.			
Mq.			
V.			
S.			
S.			
A.			
R.			
PE.			
G.			
T.D.			

Loc. in Sec. _____

SW SW SE

Geol. _____

Contr. _____

B edell & Cat

Pool _____

Wildcat

FIRST REPORT

Date Comm. 11-13-55 NOV 16 1955

8" @ 125/100 d rlg. 640

Co.

L

No.

Sec.

T.

R.

County Harvey Elev. 1407
 Sec. 11 Twp. 22 Rge. 2E
 Company Tennessee Gas & Transmission
 Farm Name Litton No. 1

TOPS	DEPTH	LOG	DATUM	Loc. in Sec.
Anh.				SW SW SE
Tr.	<u>1536</u>		<u>129</u>	
H.				
Tr.				
Dg.	<u>1838</u>		<u>1181</u>	
Bl. <u>blonged</u>	<u>1868</u>		<u>1161</u>	
L. <u>f</u>	<u>2087</u>		<u>680</u>	
K.C.				Geol.
B.K.C.				Contr.
Ce.				
C.				Bedell & Ca
M.	<u>2758</u>		<u>1351</u>	
M. <u>dela</u>	<u>2845</u>		<u>1438</u>	Pool
K.	<u>2918</u>		<u>1501</u>	
Mz.	<u>3040</u>		<u>1633</u>	Wildcat
Mo. <u>hanta</u>	<u>3044</u>		<u>1637</u>	
V. <u>mas</u>	<u>3089</u>		<u>1687</u>	
S. <u>hanta</u>	<u>3114</u>		<u>1708</u>	
A. <u>sch</u>	<u>3173</u>		<u>1766</u>	
A.	<u>3186</u>		<u>1779</u>	ABANDONED
R.				
PE.				
G.				
T.D.	<u>3250</u>			

Date Comm. 11-13-55 NOV 30 1955

8" @ 125/100 DST 3039-43 open 1 hr.

rec. 50' mud 60' sw 1085/15"

D & A