

Greenwood

Form 252A-5M-5-28-Mid-West

Map No. **KANSAS** Sec. 11 Twp. 22 R. 10

Well No. 3 - Green Farm


Phillips Pet Company

330 Ft. from N. Line

..... Ft. from S. Line

..... Ft. from E. Line

330 Ft. from W. Line

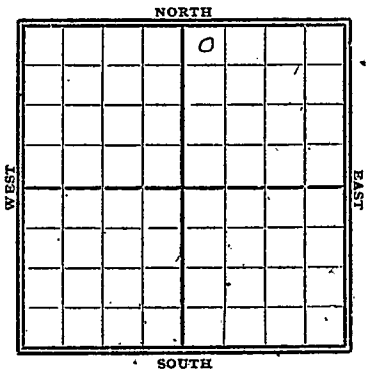

1928

Date

REPORT

11/21 Rig up

11/28 Rigging up

12/5 Spdy 160'

12/12 Core 815'

12/19 " 815'

12/26 " 1570'

1929

1/2 sand 2095' - 2132'

T.D. 2136'

shot 150 qts

235 bbls oil

Pump.

Sherwood

K21 KANSAS

MAP No. _____ SEC. 11 TWP. 22 R. 10

WELL No. 3 *Green*

Phillips Pet Co COMPANY

CONTRACTOR

SECTION PLAT

FIRST REPORTS

330 FT. FROM N. LINE

_____ FT. FROM S. LINE

_____ FT. FROM E. LINE

330 FT. FROM W. LINE

		0	

LOCATION _____

RIG UP

DRILLING AND REMARKS:

RECORD

CASED _____ IN. _____ FT.

SAND _____

GAS _____

OIL _____

TOTAL DEPTH _____

PRODUCTION

1ST 24 HRS. NAT. _____

1ST 24 HRS. AFTER SHOT _____

GAS _____ CU. FT.

DRY HOLE _____

ABANDONED _____

DATE

NOV 21 1928

CHAS. L. SHERWOOD

192 _____ SCOUT

Sherwood

Map No. **KANSAS** Sec. **11** Twp. **22** R. **10**
Well No. **3** *Green*
Phillips Pet Co Company

Contractor

COMPLETED

SECTION PLAT

330 Ft. from N. Line

Ft. from S. Line

Ft. from E. Line

330 Ft. from W. Line

		0	

Location.....

Rig up.....

Drilling and Remarks:

150/235 lbs.

RECORD

Cased *2095* in, *2137* ft.

Sand

Gas

Oil

Total Depth *2136*

PRODUCTION

1st 24 hrs. Nat.....

1st 24 hrs. after shot.....

Gas.....Cu. Ft.

Dry Hole.....

Abandoned.....

Date

JAN 2 1929

CHAS. L. SHERWOOD

192

Scout