


Map No. _____ Sec. 11 Twp. 22 R. 10
 Well No. 5-Shepherd Farm _____
Manhattan oil Company

NORTH

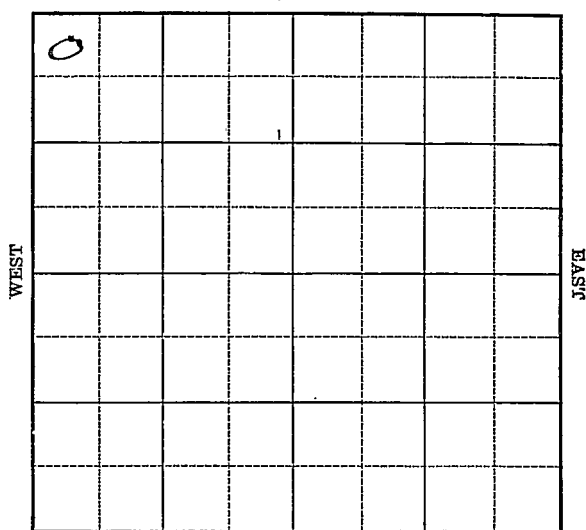

SOUTH

Location _____

Drilling Remarks _____

Rig Up _____

Drilling Remarks _____

RECORD

Cased _____ in. _____ ft.

Sand _____

Gas _____

Oil _____

Total Depth _____

PRODUCTION

1st 24 hrs. Nat. _____

1st 24 hrs. after shot _____

Gas _____ cu. ft.


Dry Hole _____

Abandoned _____

Map No. _____ Sec. 11 Twp. 22 R. 10Well No. 5 - Shepherd FarmManhattan oil Company330 Ft. from N. Line

_____ Ft. from S. Line

_____ Ft. from E. Line

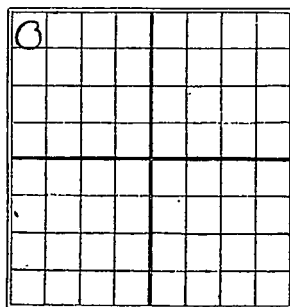330 Ft. from W. Line1927

Date

REPORT



Sherwood
 21 KANSAS
 Map No. _____ Sec. *11* Twp. *22* R. *10*
 Well No. *5* *Shepherd*
Nonhattan Oil Co. Company

Contractor

FIRST REPORTS

330 Ft. from N. Line

_____ Ft. from S. Line

_____ Ft. from E. Line

330 Ft. from W. Line

SECTION PLAT

<i>0</i>			

Location _____

Rig up _____

Drilling and Remarks:

RECORD

Cased _____ in., _____ ft.

Sand _____

Gas _____

Oil _____

Total Depth _____

PRODUCTION

1st 24 hrs. Nat. _____

1st 24 hrs. after shot _____

Gas _____ Cu. Ft.

Dry Hole _____

Abandoned _____

Date

SEP 28 1927

CHAS. L. SHERWOOD

192

Scout

21 KANSAS Sec. 11 Twp. 22 R. 10
 Map No. 5 Shepherd
 Well No. Manhattan Oil Co
 Company

Contractor

COMPLETED

SECTION PLAT

330 Ft. from N. Line

Ft. from S. Line

Ft. from E. Line

330 Ft. from W. Line

0			

Location

Rig up

Drilling and Remarks:

16.07 340 Bl.

RECORD

Cased in. ft.

Sand 7098-2151

Gas

Oil

Total Depth 2151

PRODUCTION

1st 24 hrs. Nat.

1st 24 hrs. after shot

Gas Cu. Ft.

Dry Hole

Abandoned

Date

NOV 9 - 1927

CHAS. L. SHERWOOD

192

Scout