

Map No. KANSAS Sec. 11 Twp. 22 R. 10E

Well No. 12 - Shepherd Farm
Independent Oil & Gas Company


990 Ft. from N. Line

_____ Ft. from S. Line

990 Ft. from E. Line

_____ Ft. from W. Line

1929

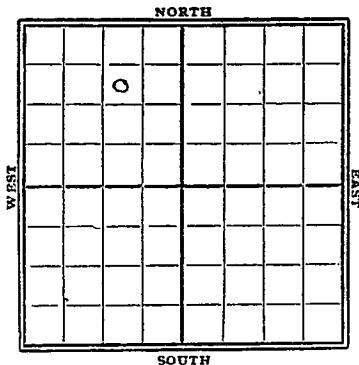

Date

REPORT

Date	REPORT
8/21	Rig up
8/28	ully 1030
9/4	" 1525'
9/11	sand 2148-76'
	first show 2153'
	T.D. 2184
	shot 100 qt
	75 bbl oil
	Comp.

Sherwood

21 Map No. **KANSAS** Sec. 11 Twp. 22 R. 10 E

Well No. 12 *Shepard*

Independent O & S Company

Contractor

FIRST REPORTS

SECTION PLAT

990 Ft. from N. Line

_____ Ft. from S. Line

990 Ft. from E. Line

_____ Ft. from W. Line

	0		

Location _____

Rig up _____

Drilling and Remarks:

Rig up

RECORD

Cased _____ in., _____ ft.

Sand _____

Gas _____

Oil _____

Total Depth _____

PRODUCTION

1st 24 hrs. Nat. _____

1st 24 hrs. after shot _____

Gas _____ Cu. Ft.

Dry Hole _____

Abandoned _____

Date

8/21 1929

CHAS. L. SHERWOOD

Scout

Greenwood

21 **KANSAS** Map No. _____ Sec. 11 Twp. 22 R. 10

Well No. 12 *Shepard*

Independent Oil Co Company _____ Contractor _____

COMPLETE

SECTION PLAT

990 Ft. from N. Line

_____ Ft. from S. Line

990 Ft. from E. Line

_____ Ft. from W. Line

	0		

Location _____

Rig up _____

Drilling and Remarks:

first show 7153

100/75 Bls

RECORD

Cased _____ in., _____ ft.

Sand 7148-7176

Gas _____

Oil _____

Total Depth 7184

PRODUCTION

1st 24 hrs. Nat. _____

1st 24 hrs. after shot _____

Gas _____ Cu. Ft.

Dry Hole _____

Abandoned _____

Date

SEP 11 1929

CHAS. L. SHERWOOD

19

Scout