
FORM 51 25M 8-50 WESTERN Greenwood KANSAS

Section 11 Township 22 Range 10E

Well No. #2 Steffes (A)

Company White & Ellis et al

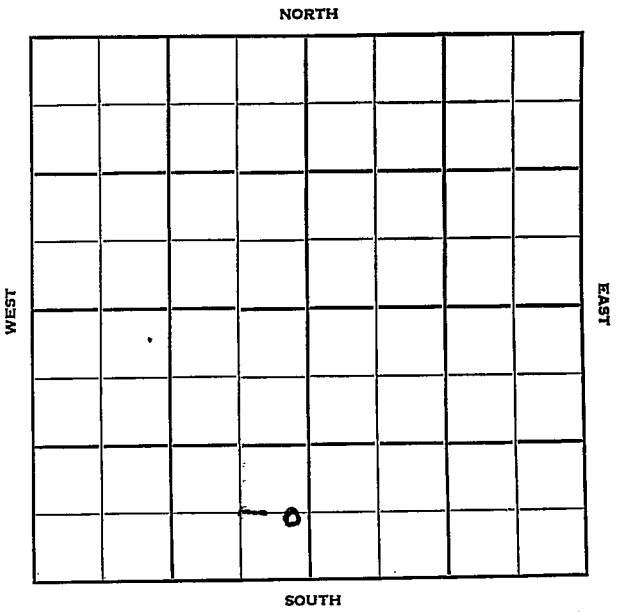

14

FORM 252-B
10M 8-51 TPCO. Greenwood KANSAS

Sec. 11 Twp. 22 R. 10E

Well No. #2 Steffes (A) Farm

White & Ellis et al Company

" Contractor


Ft. from N. Line

600 Ft. from S. Line

150 Ft. from E. Line

Ft. from W. Line

App. C E/2 SE SW

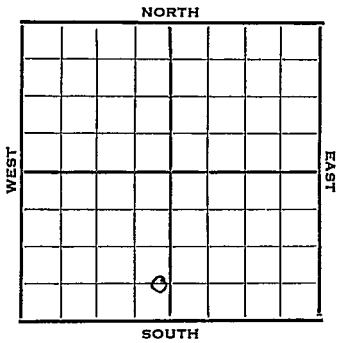

1952	Elev. - REPORT
8/27	Spud 8-25-52
9/4	Spud 8-25-52 Miss 2276 TD 2325 D&A

ABANDONED

FORM 275 FOR SALE BY KANSAS BLUE PRINT CO.


County Greenwood State Kansas

Sec. 11 (Blk. Twp.) 22 (Sur. Rge.) 10E Map No.

Operator White & Ellis etal.

Well No. 2 Farm Steffes (A)

Elev. Location App C E/2 SE SW

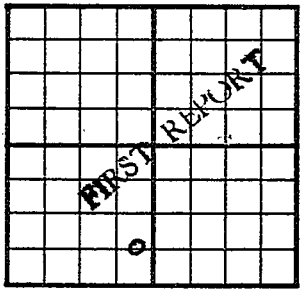

600 Ft. From S Line SW

150 Ft. From E Line Quarter

1st. Report AUG 27 1952

Completion

Remarks

White & Ellis - Contr.

Spudding Date 8-25-52

Drlg. Data

J. G. McGEHEE

FORM 275 FOR SALE BY KANSAS BLUE PRINT CO.


County Greenwood State Kansas

Sec. 11 (Blk. Twp.) 22 (Sur. Rge.) 10E Map No.

Operator White & Ellis etal.

Well No. 2 Farm Steffes "A"

Elev. Location C E L SE SW

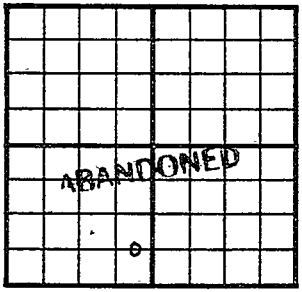

600 Ft. From S Line SW

150 Ft. From E Line Quarter

1st. Report

Completion SEP 4 1952

Remarks White & Ellis - Contr.

Spudding Date 8-25-52

Drlg. Data

Miss. 2276 TD 2325 D & A

J. G. McGEHEE