


Map No. _____ Sec. 11 Twp. 22 R. 4

Well No. 2 Larsen Farm _____
Grace Oil Co. Company _____

Contractor _____
Geo. Quarter _____

660 Ft. from N. Line
 _____ Ft. from S. Line
 _____ Ft. from E. Line
700 Ft. from W. Line

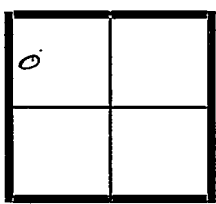

10/19

REPORT

10/13 Plugging from 2525 to 2500

10/20 Plugging back trying to shut off
water - (Sand 2492-2500) 2525'

10/30 2492-2500' - 2525' - 1008' 2525'

COMPLETED


COMPLETED

Map No. K23 Sec 11 Twp. 22 R. 4

Well No. 2 Larsen
Trace Oil Company

Contractor

NORTH

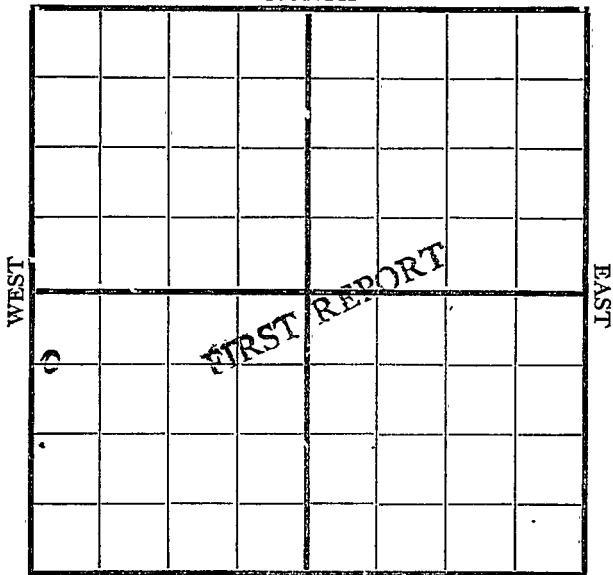

660 N

SOUTH

200 W

Location _____

Rig up _____

Drilling and Remarks:

RECORD

Cased _____ in., _____ ft.

Sand _____

Gas _____

Oil _____

Total Depth _____

PRODUCTION

1st 24 hrs. Nat. _____

1st 24 hrs. after shot _____

Gas _____ Cu. Ft.

Dry Hole _____

Abandoned _____

Date

8/14

1919

Scout

Scout

Map No. K 23 Sec. 11 Twp. 22 R. 4

Well No. 2 Larsen
Grace Oil Company

Contractor

SECTION PLAT

660 Ft. from N. Line
----- Ft. from S. Line
----- Ft. from E. Line
200 Ft. from W. Line

COMPLETED			
o			

Location -----

Rig up -----

Drilling and Remarks:

RECORD

Cased ----- in., ----- ft.
Sand 2492 - 2500
Gas -----
Oil -----
Total Depth 2525'

PRODUCTION

1st 24 hrs. Nat. 100 bbls
1st 24 hrs. after shot -----
Gas ----- Cu. Ft.
Dry Hole -----
Abandoned -----

Date

8/30 1919

Pyle

Scout