


Map No. Kansas Greenwood ✓ Sec. 11 Twp. 22 R. 12

Well No. 1 Young Farm

Shaffer & Howell Company

NORTH

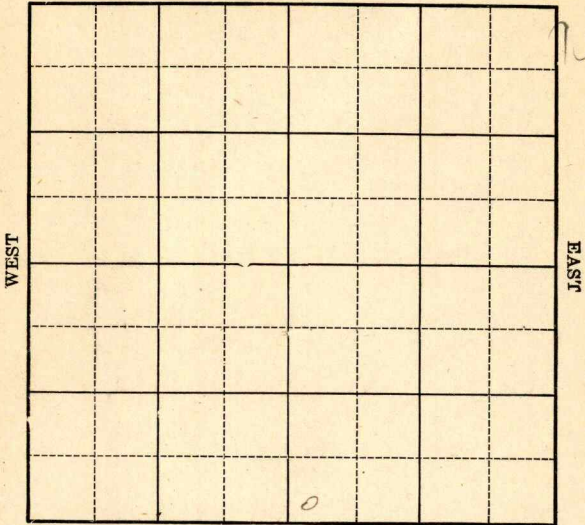

SOUTH

Location \_\_\_\_\_

Drilling Remarks \_\_\_\_\_  
\_\_\_\_\_  
\_\_\_\_\_  
Rig Up \_\_\_\_\_

Drilling Remarks \_\_\_\_\_  
\_\_\_\_\_  
\_\_\_\_\_  
**RECORD**

Cased \_\_\_\_\_ in. \_\_\_\_\_ ft.

Sand \_\_\_\_\_

Gas \_\_\_\_\_

Oil \_\_\_\_\_

Total Depth \_\_\_\_\_

**PRODUCTION**

1st 24 hrs. Nat. \_\_\_\_\_

1st 24 hrs. after shot \_\_\_\_\_

Gas \_\_\_\_\_ cu. ft.

Dry Hole \_\_\_\_\_

Abandoned \_\_\_\_\_



*Sherwood*

Map No. *K21* KANSAS Sec. *11* Twp. *22* R. *12*

Well No. *1* *Young*

*Shannon & Howell* Company

Contractor

COMPLETED

SECTION PLAT

Ft. from N. Line

*330*

Ft. from S. Line

Ft. from E. Line

*330*

Ft. from W. Line

ABANDONED

		<i>0</i>	

Location

Rig up

Drilling and Remarks:

*Top limo 1850'*

*D Ca*

*1977*

RECORD

Cased \_\_\_\_\_ in., \_\_\_\_\_ ft.

Sand *1690-1775* *Pen.*

Gas \_\_\_\_\_

Oil \_\_\_\_\_

Total Depth *1977'*

PRODUCTION

1st 24 hrs. Nat. \_\_\_\_\_

1st 24 hrs. after shot \_\_\_\_\_

Gas \_\_\_\_\_ Cu. Ft.

Dry Hole

Abandoned

Date

JUN 17 1926

CHAS. L. SHERWOOD

192

Scout

*Steenwood*

*K21*

**KANSAS**

Map No. \_\_\_\_\_ Sec. *11* Twp. *22* R. *12*

Well No. *1* \_\_\_\_\_

*Young*  
*Shaffer & Howell*

Company

Contractor

**FIRST REPORTS**

**SECTION PLAT**

\_\_\_\_\_ Ft. from N. Line

*330* Ft. from S. Line

\_\_\_\_\_ Ft. from E. Line

*330* Ft. from W. Line

		o	

Location  \_\_\_\_\_

Rig up \_\_\_\_\_

Drilling and Remarks:

**RECORD**

Cased \_\_\_\_\_ in., \_\_\_\_\_ ft.

Sand \_\_\_\_\_

Gas \_\_\_\_\_

Oil \_\_\_\_\_

Total Depth \_\_\_\_\_

**PRODUCTION**

1st 24 hrs. Nat. \_\_\_\_\_

1st 24 hrs. after shot \_\_\_\_\_

Gas \_\_\_\_\_ Cu. Ft.

Dry Hole \_\_\_\_\_

Abandoned \_\_\_\_\_

Date

**MAR 25 1926**

**CHAS. L. SHERWOOD**

192

Scout