

KANSAS

Form 51-5M-7-40-Palace

Coffey




Section 11 Township 22 Range 13-E

Well No. 1 Isch

Company Aikman & Braden

NORTH Miscellaneous

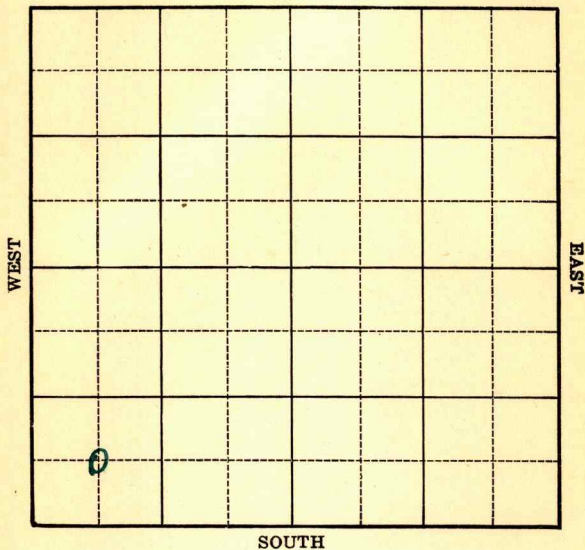

Sec. 11 Twp. 22 R. 13-E

Well No. #1 Isch Farm

Aikman & Braden Company


(Misc.)

_____Ft. from N. Line

660 Ft. from S. Line

Ft. from E. Line

660 Ft. from W. Line

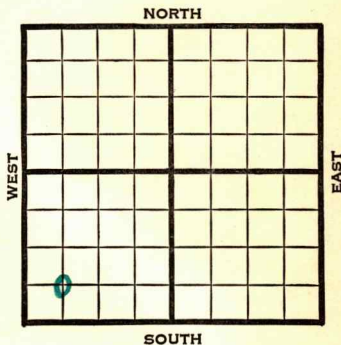[illegible]

Map No. 20 Sec. 11 Twp. 22 R. 13EWell No. 1 IschAikman & Braden

Company

FIRST REPORT

Contractor

C SW SW

 Ft. from N. Line660 Ft. from S. Line Ft. from E. Line660 Ft. from W. Line

MISCELLANEOUS

SECTION PLAT

o			

Location XRig up

Drilling and Remarks:

RECORD

Cased in., ft.Sand Gas Oil Total Depth

PRODUCTION

1st 24 hrs. Nat. 1st 24 hrs. after shot Gas Cu. Ft.Dry Hole Abandoned

Date

MAY 14 1941S. J. LEWIS

Scout

Map No. 20 Sec. 11 Twp. 22 R. 13EWell No. 1 IschAikman & Braden

Company

Contractor

ABANDONED

C SW SW

Ft. from N. Line

660

Ft. from S. Line

Ft. from E. Line

660

Ft. from W. Line

MISCELLANEOUS

SECTION PLAT

o			

Location

Rig up

Drilling and Remarks:

*Miss 1833**Water.*

RECORD

Cased _____ in., _____ ft.

Sand _____

Gas _____

Oil _____

Total Depth 1868

PRODUCTION

1st 24 hrs. Nat. _____

1st 24 hrs. after shot _____

Gas _____ Cu. Ft.

Dry Hole _____

Abandoned _____

Date

JUN 18 1941

19

S. J. LEWIS

Scout