


Coffey

KANSAS

SECTION 11 TOWNSHIP 22S RANGE 13E

WELL NO. #7 Sam Isch

COMPANY Aikman-Braden

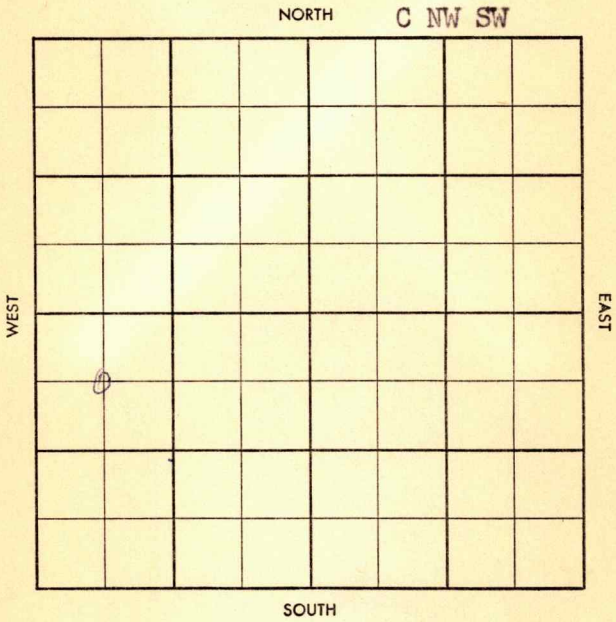

~~Top~~ ~~Pool~~
~~Co.~~ ~~Facot~~

S-513-B

County Coffey Elev. _____
 Sec. 11 Twp. 22 Rge. 13E
 Company Aikman-Bradén
 Farm Name Sam Isch No. 7

TOPS	DEPTH	LOG	DATUM
Anh.			
Tp.			
H.			
Tr.			
Dg.			
B.L.			
L.			
K.C.			
B.K.C.			
Ce.			
C.			
M.			
M.			
K.			
Mz.			
Mq.			
V.			
S.			
S.			
A.			
R.			
Pf.			
G.			
T.D.			

Loc. in Sec. C NW SW
 Geol. _____
 Contr. Howard Newlan
 Pool Hubbard

JUN 18 1918
FIRST REPORT

Date Comm. _____

MICT

Co. _____
 L. Sec. _____
 No. _____
 Sec. _____
 T. _____
 R. _____

~~Two~~ Pool ~~Pool~~

~~Ch...~~ Facet ~~Facet~~

S-513-B

County Coffey Elev. _____
 Sec. 11 Twp. 22 Rge. 13E
 Company Aikman-Bradon Wichita Elder
 Farm Name Sam Isch No. 7

TOPS	DEPTH	LOG	DATUM	Loc. in Sec.
Anh.				C NW SW
Tp.				
H.				
Tr.				
Dg.				
B.L.				
L. <u>Burgess 806</u>				
K.C.				Geol.
B.K.C.				Contr.
Ce.				<u>Howard Newland</u>
C.				Pool
M.				<u>Hubbard</u>
M.				
K.				
Mz.				
Mq.				
V.				
S.				
S.				
A.				
R.				
Pf.				
G.				
T.D.	<u>1811</u>			

COMPLETE
 0
 JUL 9 '58

Date Comm. 6-17-58 8" 135

MICT JUN 25 '58, 5" 1805 CO 1811

pop JUL 2 '58, JUL 9 '58 P17 1/2 B0

+w. pd

P15 B0pd + w

Burgess 1906-11

⊕