DX 78-1 Greenwood KANSAS

Section 11 Township 22 Range 11E

Well No. #1 Hind

Company Barnard Pet.

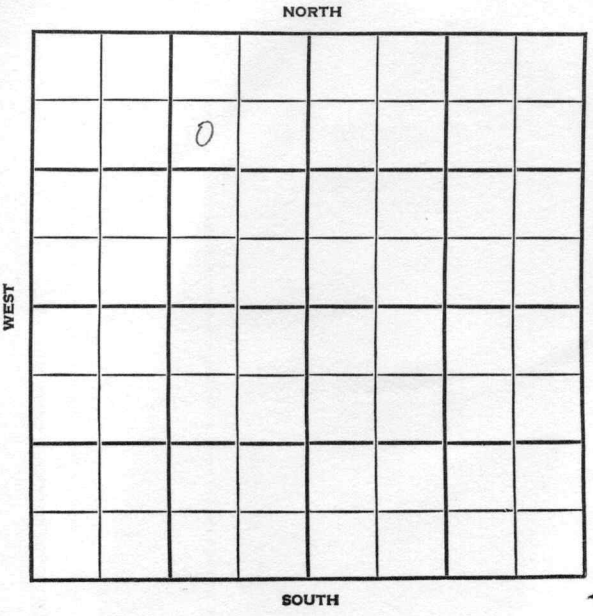

3

Greenwood KANSAS

SEC.	TWP.	R.
11	22	11E

WELL NO.

#1 Hind FARM

COMPANY

Barnard Petr.

CONTRACTOR

Co. Tools

Madison

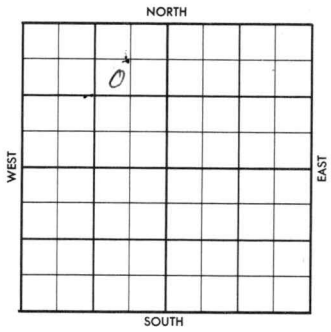

_____ FT. FROM N. LINE

_____ FT. FROM S. LINE

_____ FT. FROM E. LINE

_____ FT. FROM W. LINE

SW NE NW

1956	ELEVATION REPORT
7-18	Comm. 7-16-56
7-25	8 5/8" @ 58 w/55 D & A Sd Sh. 1700' TD 1856'

ABANDONED

FORM 504-5 SUNRAY

FORM 513 SUNRAY

County Greenwood Elev.

Sec. 11 Twp. 22 Rge. 11E

Company Barnard Pet.

Farm Name Hind No. 1

TOPS	DEPTH	LOG	DATUM
Anh.			
T.p.			
H.			
Tr.			
Dg.			
B.L.			
L.			
K.C.			
B.K.C.			
Ce.			
C.			
M.			
M.			
K.			
Mz.			
Mo.			
V.			
S.			
S.			
A			
R.			
P€.			
G.			
T.D.			

Loc. in Sec. SW NE NW

Geol.

Contr. Co. tools

Pool Madison



FIRST REPORT

JUL 18 '56

Date Comm. 7-16-56

Co. Lse. No. Sec. T. R.

FORM 513 SUNRAY

County Creamwood Elev.

Sec. 11 Twp. 22 Rge. 11E

Company Barnard Pet.

Farm Name Hind No. 1

TOPS	DEPTH	LOG	DATUM
Anh.			
Tp.			
H.			
Tr.			
Dg.			
B.L.			
L.			
K.C.			
B.K.C.			
Ce.			
~~E~~ Sd Sh	1700		
M.			
M.			
K.			
Mz.			
Mo.			
V.			
S.			
S.			
A			
R.			
P€.			
G.			
T.D.	1856		

Loc. in Sec. SW NE NW

Geol.

Contr. Co. tools

Pool Madison

ABANDONED

JUL 25 1956

Date Comm. 7-16-56 JUL 25 '56 8 5/8 58/55

D & A

Co. Lse. No. Sec. T. R.