



*Kansas*

Map No. \_\_\_\_\_ Sec. 11 Twp. 22 R. 11


Well No. 1-Bond Farm \_\_\_\_\_  
John Stark-White Eagle Company

\_\_\_\_\_ Ft. from N. Line

330 Ft. from S. Line

330 Ft. from E. Line

\_\_\_\_\_ Ft. from W. Line

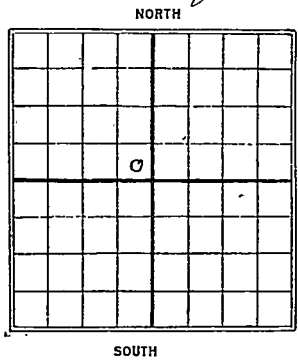

1927

Date

REPORT

2/3 Location

2/10 \_\_\_\_\_

2/17 \_\_\_\_\_

2/24 abandoned location

*Bleedwood*

**21 KANSAS**

Map No. \_\_\_\_\_ Sec. *11* Twp. *22* R. *11*

Well No. *1 Hind*

*John Stark & White Eagle* Company

Contractor

**FIRST REPORTS**


**SECTION PLAT**

\_\_\_\_\_ Ft. from N. Line

*330* Ft. from S. Line

*330* Ft. from E. Line

\_\_\_\_\_ Ft. from W. Line

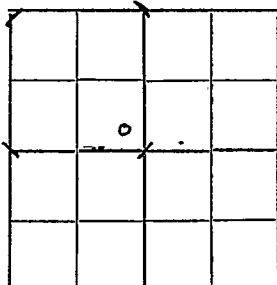

Location  \_\_\_\_\_

Rig up \_\_\_\_\_

Drilling and Remarks:

**RECORD**

Cased \_\_\_\_\_ in., \_\_\_\_\_ ft.

Sand \_\_\_\_\_

Gas \_\_\_\_\_

Oil \_\_\_\_\_

Total Depth \_\_\_\_\_

**PRODUCTION**

1st 24 hrs. Nat. \_\_\_\_\_

1st 24 hrs. after shot \_\_\_\_\_

Gas \_\_\_\_\_ Cu. Ft.

Dry Hole \_\_\_\_\_

Abandoned \_\_\_\_\_

Date

DEC 3 1927

**CHAS. L. SHERWOOD**

192

Scout

*Sherwood*

21 KANSAS Map No. Sec. 11 Twp. 22 R. 11

Well No. 1 *Hand*

*John Stars & White Eagle* Company

Contractor

COMPLETED

SECTION PLAT

----- Ft. from N. Line  
*330*  
----- Ft. from S. Line  
*330*  
----- Ft. from E. Line  
----- Ft. from W. Line


ABANDONED

Location -----  
Rig up -----  
Drilling and Remarks:

RECORD

Cased ~~in.~~ ft.  
Sand -----  
Gas -----  
Oil -----  
Total Depth -----

PRODUCTION

1st 24 hrs. Nat. -----  
1st 24 hrs. after shot -----  
Gas ----- Cu. Ft.  
Dry Hole -----  
Abandoned *Location*

*Wds Location*

Date  
FEB 24 1927

CHAS. L. SHERWOOD  
Scout