

Map No. Kansas Sec. 11 Twp. 22 R. 11

Well No. 2 Kupper Farm


Tidal Oil Co. Company

..... Ft. from N. Line

330 Ft. from S. Line

320 Ft. from E. Line

..... Ft. from W. Line

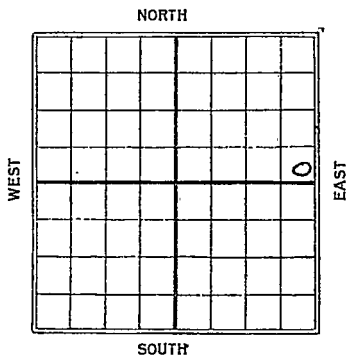

Date	REPORT
<u>1925</u>	
<u>4/24</u>	<u>R. O. G.</u>
<u>5/29</u>	<u>1792-1827 T.D. 1832</u>
	<u>80 gts 260 Bbls</u>

Map No. 21 N 40 As Sec. 11 Twp. 22 R. 11

Well No. 2
Fidel Oil Co. Company

Contractor

FIRST REPORTS

SECTION PLAT

_____ Ft. from N. Line

330 Ft. from S. Line

330 Ft. from E. Line

_____ Ft. from W. Line

			0

Location _____

Rig up on ground

Drilling and Remarks:

RECORD

Cased _____ in., _____ ft.

Sand _____

Gas _____

Oil _____

Total Depth _____

PRODUCTION

1st 24 hrs. Nat. _____

1st 24 hrs. after shot _____

Gas _____ Cu. Ft.

Dry Hole _____

Abandoned _____

Date

APR 24 1925

192

Chas. S. Sherwood
 Scout

Map No. 15440 Sec. 11 Twp. 22 R. 11

Well No. 2 Reper
Red Oil Co Company

Contractor

COMPLETED

SECTION PLAT

----- Ft. from N. Line
330 Ft. from S. Line
330 Ft. from E. Line
----- Ft. from W. Line

Location -----

Rig up -----

Drilling and Remarks:

809 260 bls

RECORD

Cased in., ft.
Sand 1792-1827
Gas -----
Oil -----
Total Depth 1832

PRODUCTION

1st 24 hrs. Nat. -----
1st 24 hrs. after shot -----
Gas ----- Cu. Ft.
Dry Hole -----
Abandoned -----

Date
MAY 29 1925
----- 192

CHAS. L. SHERWOOD
Scout