


Map No. Kan Sec. 11 Twp. 22 R. 11
Well No. 4 Kipper Farm
Tidal Oil Company

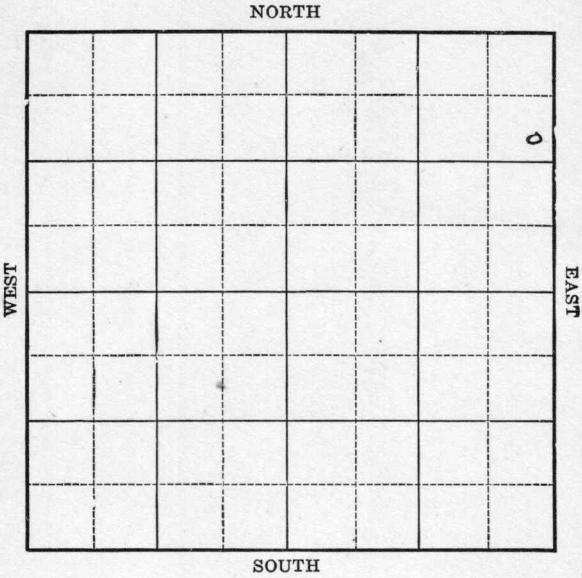

Location _____
Drilling Remarks _____

RECORD

Cased _____ in. _____ ft.
Sand _____
Gas _____
Oil _____
Total Depth _____

Rig Up _____
Drilling Remarks _____

PRODUCTION

1st 24 hrs. Nat. _____
1st. 24 hrs. after shot _____
Gas _____ cu. ft.
Dry Hole _____
Abandoned _____


Map No. Kaw Sec. 11 Twp. 22 R. 11Well No. 4 Kipper Farm
Tidal Oil Co. Company990 Ft. from N. Line

Ft. from S. Line

330 Ft. from E. Line

Ft. from W. Line

NORTH

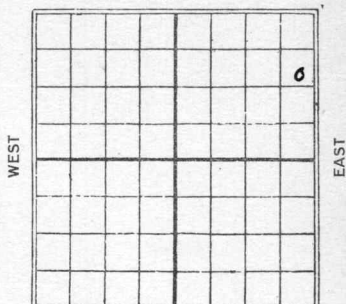

SOUTH

C

Date 1925 REPORT6/26 Location7/3 Rig7/107/15 sq 7507/24 Calg. 875'7/31 1275'8/7 top s. 1746-6" - net oil 1769-
1861 - 7.D. 1825' 100' oil
in hole not.shot 160 gts - No est.8/14 No change8/20 1746-1825 160 gts
40 Bbls




Contractor _____

FIRST REPORTS

990 Ft. from N. Line

_____ Ft. from S. Line

330 Ft. from E. Line

_____ Ft. from W. Line

SECTION PLAT

			0

Location ✓ _____

Rig up _____

Drilling and Remarks:

RECORD

Cased _____ in., _____ ft.

Sand _____

Gas _____

Oil _____

Total Depth _____

PRODUCTION

1st 24 hrs. Nat. _____

1st 24 hrs. after shot _____

Gas _____ Cu. Ft.

Dry Hole _____

Abandoned _____

Date

JUN 26 1925 CHAS. L. SHERWOOD
192 Scout

21 KANSAS Sec. 11 Twp. 22 R. 11

Well No. 4
Lidal Oil Co

Company

Contractor

COMPLETED

SECTION PLAT

990 Ft. from N. Line

Ft. from S. Line

330 Ft. from E. Line

Ft. from W. Line

Location

Rig up

Drilling and Remarks:

oil 1769-1821'
1609 40 bhs

RECORD

Cased in., ft.

Sand 1746 1825'

Gas

Oil

Total Depth 1825'

PRODUCTION

1st 24 hrs. Nat.

1st 24 hrs. after shot

Gas Cu. Ft.

Dry Hole

Abandoned

Date

AUG 20 1925

192

CHAS. L. SHERWOOD

Scout