

Map No. Frank Sec. 4 Twp. 22 R. 12
 Well No. 2 Frankhouser Farm
Empire-Lamar-Haus Company

NORTH



SOUTH

Location _____

Drilling Remarks _____

Rig Up _____

Drilling Remarks _____

RECORD

Cased _____ in. _____ ft.

Sand _____

Gas _____

Oil _____

Total Depth _____

PRODUCTION

1st 24 hrs. Nat. _____

1st 24 hrs. after shot _____

Gas _____ cu. ft.

Dry Hole _____

Abandoned _____

Map No. Frank Sec. 4 Twp. 22 R. 12
 Well No. # 2 Frankhouser Farm
Empire-Lamar-Haus Company

NORTH

_____ Ft. from N. Line

1016 FSL


990 Ft. from S. Line

1629

Ft. from E. Line

990 Ft. from W. Line

1926.

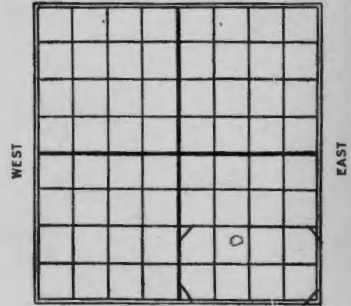

SOUTH

Date

REPORT

5/21 Rign
6/2 drly 850'
6/10 fishing bit at 1400'
6/18 top sd. 1782-1824 filled up
1000' natural, shot 140 gts
swabbed 470 bbls 1st 24 hrs
6/24 Sand 1782-1824 140 gts
450 bbls

Sherwood

K21 KANSAS
Map No. 2 Sec. 4 Twp. 22 R. 12

Well No. 2
Empire-Lamar & Hane Company

Contractor

COMPLETED

SECTION PLAT

990 1016 Ft. from N. Line
1629 Ft. from S. Line
1629 Ft. from E. Line
990 Ft. from W. Line

Location
Rig up
Drilling and Remarks:

140g 450 BS.

RECORD
Cased _____ in., _____ ft.
Sand *1782-1824*
Gas _____
Oil _____
Total Depth *1824*

PRODUCTION
1st 24 hrs. Nat. _____
1st 24 hrs. after shot _____
Gas _____ Cu. Ft.
Dry Hole _____
Abandoned _____

Date
JUN 24 1926

CHAS. L. SHERWOOD
Scout

Sherwood

K21 KANSAS
Map No. 2 Sec. 4 Twp. 22 R. 12

Well No. 2
Empire-Lamar & Hane Company

Contractor

FIRST REPORTS

SECTION PLAT

990 1016 Ft. from N. Line
1629 Ft. from S. Line
1629 Ft. from E. Line
990 Ft. from W. Line

Location ✓
Rig up ✓
Drilling and Remarks:

RECORD
Cased _____ in., _____ ft.
Sand _____
Gas _____
Oil _____
Total Depth _____

PRODUCTION
1st 24 hrs. Nat. _____
1st 24 hrs. after shot _____
Gas _____ Cu. Ft.
Dry Hole _____
Abandoned _____

Date
MAY 21 1926

CHAS. L. SHERWOOD
Scout