


Greenwood  
 Map No. Kansas Sec. 4 Twp. 22 R. 12  
 Well No. 2 Frankhouser Farm  
Fisher-Lauck Company

NORTH

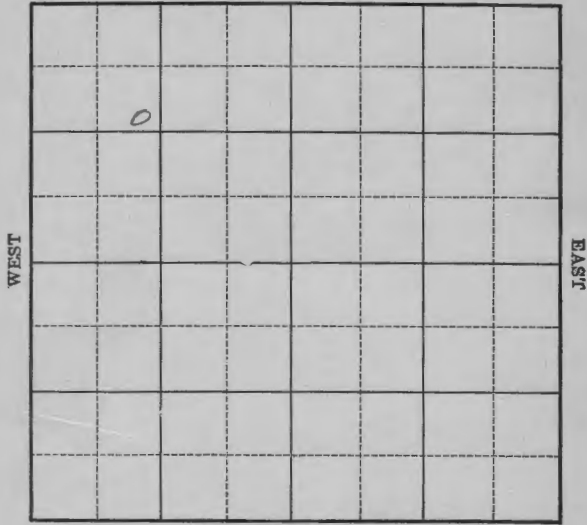

SOUTH

Location \_\_\_\_\_

Drilling Remarks \_\_\_\_\_

Rig Up \_\_\_\_\_

Drilling Remarks \_\_\_\_\_

**RECORD**

Cased \_\_\_\_\_ in. \_\_\_\_\_ ft.  
 Sand \_\_\_\_\_  
 Gas \_\_\_\_\_  
 Oil \_\_\_\_\_  
 Total Depth \_\_\_\_\_


**PRODUCTION**

1st 24 hrs. Nat. \_\_\_\_\_  
 1st 24 hrs. after shot \_\_\_\_\_  
 Gas \_\_\_\_\_ cu. ft.  
 Dry Hole \_\_\_\_\_  
 Abandoned \_\_\_\_\_

Greenwood  
 Map No. Kansas Sec. 4 Twp. 22 R. 12  
 Well No. 2 Frankhouser Farm  
Fisher-Lauck Company

NORTH

990 Ft. from N. Line  
 \_\_\_\_\_ Ft. from S. Line  
 \_\_\_\_\_ Ft. from E. Line  
990 Ft. from W. Line

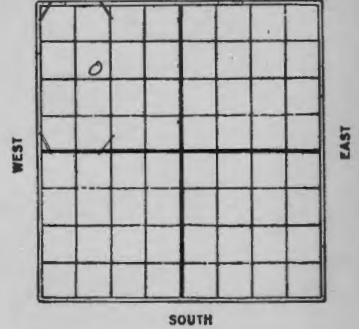

Date

**REPORT**

1926  
 3/18 Bldg Rig  
 3/25 Rig  
 4/1 \_\_\_\_\_  
 4/7 \_\_\_\_\_  
 4/14. Sdg 1400  
 421 Top sd 1868-1917 J.D. 1922  
 300 oil. shot 180/C.O.  
 429 Sd. 1868-1917-1922.  
 180/200 Bbls.

*Sherwood*

Map No. *K21* KANSAS Sec. *4* Twp. *22* R. *12*

Well No. *2* *Francis Houston*  
*Fisher & Lauer* Company

Contractor

FIRST REPORTS

*990* Ft. from N. Line  
..... Ft. from S. Line  
..... Ft. from E. Line  
*990* Ft. from W. Line

SECTION PLAT

|   |  |  |  |
|---|--|--|--|
| 0 |  |  |  |
|   |  |  |  |
|   |  |  |  |
|   |  |  |  |

Location .....  
Rig up .....

Drilling and Remarks:

*Block Rig*

RECORD

Cased..... in., ..... ft.  
Sand .....  
Gas .....  
Oil .....  
Total Depth.....

PRODUCTION

1st 24 hrs. Nat. ....  
1st 24 hrs. after shot.....  
Gas..... Cu. Ft.  
Dry Hole.....  
Abandoned.....

Date

MAR 18 1926

CHAS. L. SHERWOOD  
192 Scout

*Sherwood*

Map No. *K21* KANSAS Sec. *4* Twp. *22* R. *12*

Well No. *2* *Francis Houston*  
*Fisher & Lauer* Company

Contractor

COMPLETED

*990* Ft. from N. Line  
..... Ft. from S. Line  
..... Ft. from E. Line  
*990* Ft. from W. Line

SECTION PLAT

|   |  |  |  |
|---|--|--|--|
| 0 |  |  |  |
|   |  |  |  |
|   |  |  |  |
|   |  |  |  |

Location .....  
Rig up .....

Drilling and Remarks:

*1800 / 200 fls.*

RECORD

Cased..... in., ..... ft.  
Sand *1868-1917*  
Gas .....  
Oil .....  
Total Depth *1922'*

PRODUCTION

1st 24 hrs. Nat. ....  
1st 24 hrs. after shot.....  
Gas..... Cu. Ft.  
Dry Hole.....  
Abandoned.....

Date

APR 28 1926

192 CHAS. L. SHERWOOD  
Scout