


Map No. Sec. 1 Twp. 22 R. 12
Well No. 2 Frankhouse Farm
Texas Company Company

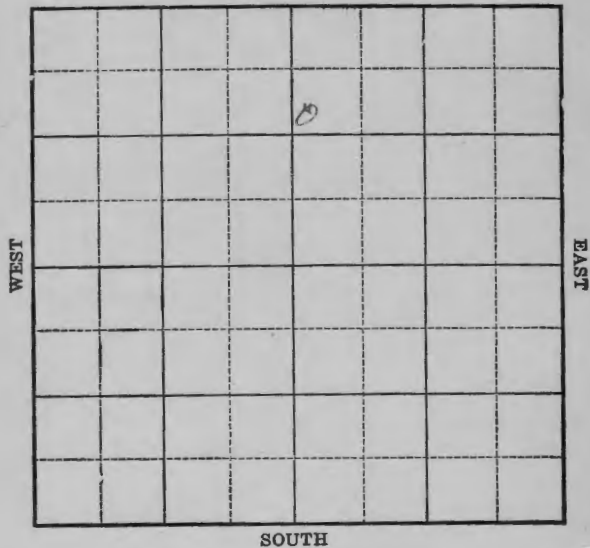

Location _____
Drilling Remarks _____

Rig Up _____
Drilling Remarks _____

RECORD


PRODUCTION

Cased _____ in. _____ ft.
Sand _____
Gas _____
Oil _____
Total Depth _____

1st 24 hrs. Nat. _____
1st 24 hrs. after shot _____
Gas _____ cu. ft.
Dry Hole _____
Abandoned _____

Map No. Kansas Sec. 4 Twp. 22 R. 12
Well No. 2 Frankhouse Farm
Texas Company Company

990 Ft. from N. Line
4243 Ft. from S. Line
2292 Ft. from E. Line
330 Ft. from W. Line

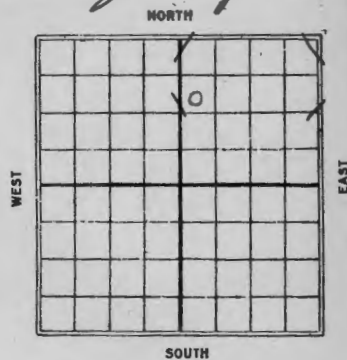

Date 1926

REPORT

5/5 Rig up
5/18 Done
5/19 Rig up.
6/2 Drly. 1000'
6/9 Sand 1810-1840 T.D. 1860
100 gts 75 bbls

Sherwood
K21 KANSAS
Map No. Sec. 4 Twp. 22 R. 12
Well No. 2 *Flanshaw*
Tex Co Company

COMPLETED

990 Ft. from N. Line
4243 Ft. from S. Line
2292 Ft. from E. Line
330 Ft. from W. Line

SECTION PLAT

		0	

Location -----
Rig up -----
Drilling and Remarks:

1007/75 ss.

RECORD

Cased _____ in., _____ ft.
Sand *1810-1840*
Gas -----
Oil -----
Total Depth *1860'*

PRODUCTION

1st 24 hrs. Nat. -----
1st 24 hrs. after shot -----
Gas ----- Cu. Ft.
Dry Hole -----
Abandoned -----

Date
JUN 9 1926

192 CHAS. L. SHERWOOD
Scout

Sherwood
K21 KANSAS
Map No. Sec. 4 Twp. 22 R. 12
Well No. 2 *Flanshaw*
Tex Co Company

SECTION PLAT

990 Ft. from N. Line
4243 Ft. from S. Line
2292 Ft. from E. Line
330 Ft. from W. Line

		0	

FIRST REPORTS

Location -----
Rig up
Drilling and Remarks:

RECORD

Cased _____ in., _____ ft.
Sand -----
Gas -----
Oil -----
Total Depth -----

PRODUCTION

1st 24 hrs. Nat. -----
1st 24 hrs. after shot -----
Gas ----- Cu. Ft.
Dry Hole -----
Abandoned -----

Date
MAY 5 1926

192 CHAS. L. SHERWOOD
Scout