


*Greenwood*

Map No. *Kansas* Sec. *4* Twp. *22* R. *12*

Well No. *3 Frankhouser* Unit 3 Farm

*Empire-Lamar-Hane* Company

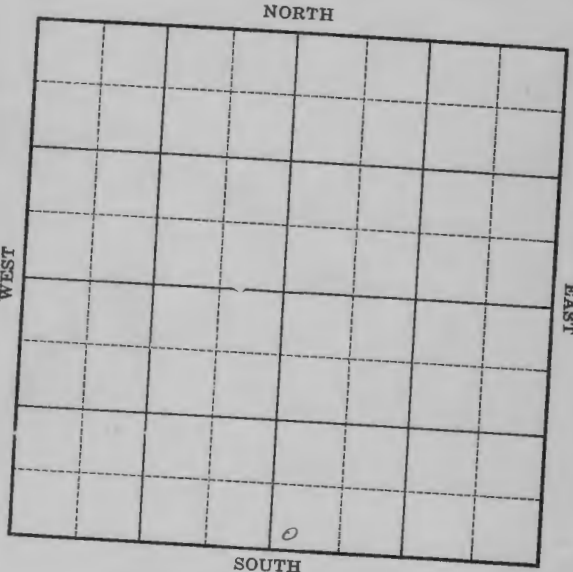

Location \_\_\_\_\_  
Drilling Remarks \_\_\_\_\_

Rig Up \_\_\_\_\_  
Drilling Remarks \_\_\_\_\_

**RECORD**

Cased \_\_\_\_\_ in. \_\_\_\_\_ ft.  
 Sand \_\_\_\_\_  
 Gas \_\_\_\_\_  
 Oil \_\_\_\_\_  
 Total Depth \_\_\_\_\_


**PRODUCTION**

1st 24 hrs. Nat. \_\_\_\_\_  
 1st 24 hrs. after shot \_\_\_\_\_  
 Gas \_\_\_\_\_ cu. ft.  
 Dry Hole \_\_\_\_\_  
 Abandoned \_\_\_\_\_

Map No. *Kans* Sec. *4* Twp. *22* R. *12*

Well No. *#3 Frankhouser* Unit 3 Farm

*Empire-Lamar-Hane* Company

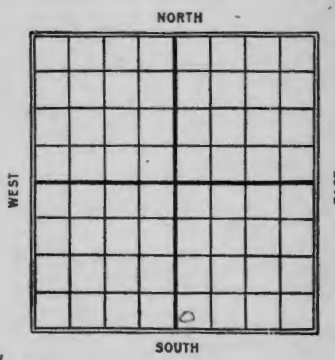

\_\_\_\_\_ Ft. from N. Line  
*339*  
~~330~~ Ft. from S. Line  
*2277* Ft. from E. Line  
~~330~~ Ft. from W. Line

*1926.* *Offshore*  
Date REPORT

*5/21 Timbers*  
*6/2 Rig*  
*6/10 Drlg 475*  
*6/21 Top sand & 1st oil*  
*1806 T.D. 1827 in sand*  
*showing little water*  
*filled up 400 ft*  
*oil in 6 hrs Well*  
*shook out 75 bbl (reg)*  
*6/25 Sdy shale 1766-1806'*  
*6" 1766' top sand & 1st oil*  
*at 1806-1827; filled up*  
*400 ft natural; P.B. to 1823;*  
*shot 60 grt, made 130 bbl*  
*1st 17 hrs swabbing & C.O.*  
*showing small amount of water*  
*6-26 swabbing 125 BS oil and 125*  
*BS water.*  
*7/7 Swabbed 18 bbl per day*  
*making 100 bbls oil 10 water (24)*  
*7/21 Sand 1806-27 Sdy shale*  
*1766-1806, P.B. to 1823*  
*(over)*



60/ 100 bbls oil

20 " water

T.D. 1827 feet.



K21 KANSAS  
Map No. 3 Sec. 4 Twp. 22 R. 12  
Well No. 3 Frank Houston Unit 3  
Combit-Lamar & Hane Company

*Stobenwood*

Contractor

COMPLETED

SECTION PLAT

Ft. from N. Line  
330 339  
Ft. from S. Line  
227  
Ft. from E. Line  
330  
Ft. from W. Line


*offset*

Location -----

Rig up -----

Drilling and Remarks:

*sd. shal 1766-1806*

*Plugged back to 1925  
by 100 BS oil  
20 BS water*

Date

JUL 2 1 1926

RECORD

Cased 1806-1827 in., 1827 ft.

Sand -----

Gas -----

Oil -----

Total Depth 1827

PRODUCTION

1st 24 hrs. Nat. -----

1st 24 hrs. after shot -----

Gas ----- Cu. Ft.

Dry Hole -----

Abandoned -----

CHAS. L. SHERWOOD

Scout

K21 KANSAS  
Map No. 3 Sec. 4 Twp. 22 R. 12  
Well No. 3 Frank Houston Unit 3  
Combit-Lamar & Hane Company

*Stobenwood*

Contractor

FIRST REPORTS

SECTION PLAT

Ft. from N. Line  
330 339  
Ft. from S. Line  
227  
Ft. from E. Line  
330  
Ft. from W. Line


*offset*

Location -----

Rig up -----

Drilling and Remarks:

*2unks*

RECORD

Cased ----- in., ----- ft.

Sand -----

Gas -----

Oil -----

Total Depth -----

PRODUCTION

1st 24 hrs. Nat. -----

1st 24 hrs. after shot -----

Gas ----- Cu. Ft.

Dry Hole -----

Abandoned -----

Date  
MAY 2 1 1926

CHAS. L. SHERWOOD

Scout