


Map No. K Sec. 4 Twp. 22 R. 12
 Well No. 4 Frankhouser Farm
Empire Lumar - Kane Company

NORTH

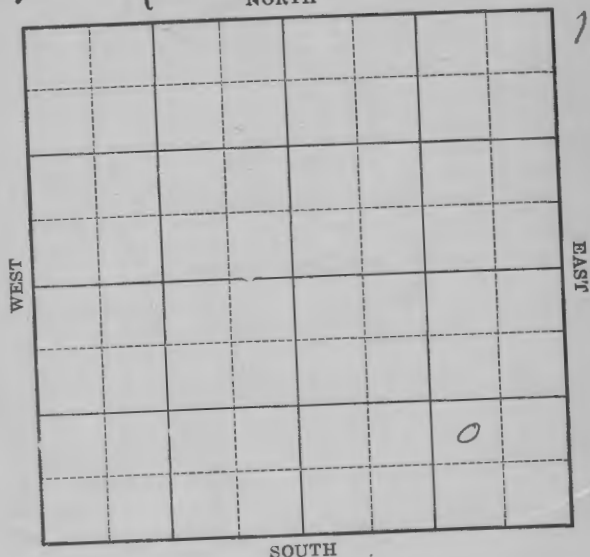

SOUTH

Location _____
 Drilling Remarks _____

Rig Up _____
 Drilling Remarks _____

RECORD


Cased _____ in. _____ ft.
 Sand _____
 Gas _____
 Oil _____
 Total Depth _____

PRODUCTION

1st 24 hrs. Nat. _____
 1st 24 hrs. after shot _____
 Gas _____ cu. ft.
 Dry Hole _____
 Abandoned _____

Map No. Kansas Sec. 4 Twp. 22 R. 12
 Well No. 4 Frankhouser Farm
Empire Lumar & Kane Company

NORTH

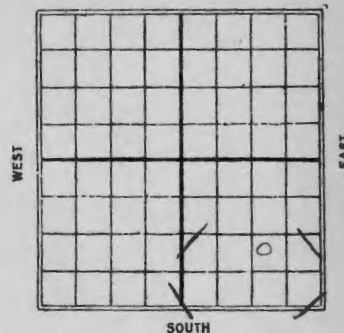

SOUTH

_____ Ft. from N. Line

990 Ft. from S. Line990 Ft. from E. Line

_____ Ft. from W. Line

Date

REPORT

19266/246-307/87/157/21Rig uponly 585965sd. 1807-24' shale 182464' plugged back to1824' 200' oil in holeSand 1807-24Shale 1824-64, P.B. to1824, 60/120 Bbls oil15 bbls water, T.D. 1864

K21 KANSAS Sec. 4 Twp. 22 R. 12

Well No. 4 Frank Shouder
Empire Lumber & Hardware Company

Contractor

FIRST REPORTS

Ft. from N. Line

990 Ft. from S. Line

990 Ft. from E. Line

Ft. from W. Line

SECTION PLAT

Location

Rig up ✓

Drilling and Remarks:

RECORD

Cased in. ft.

Sand

Gas

Oil

Total Depth

PRODUCTION

1st 24 hrs. Nat.

1st 24 hrs. after shot

Gas Cu. Ft.

Dry Hole

Abandoned

Date

JUN 24 1926

CHAS. L. SHERWOOD

192

Scout

K21 KANSAS Sec. 4 Twp. 22 R. 12

Well No. 4 Frank Shouder
Empire Lumber & Hardware Company

Contractor

COMPLETED

Ft. from N. Line

990 Ft. from S. Line

990 Ft. from E. Line

Ft. from W. Line

SECTION PLAT

Location

Rig up

Drilling and Remarks:

Shale 1824-1864

Plugged back to 1824

by 120 SS at
15 SS water.

RECORD

Cased in. ft.

Sand 1807 1824

Gas

Oil

Total Depth 1864

PRODUCTION

1st 24 hrs. Nat.

1st 24 hrs. after shot

Gas Cu. Ft.

Dry Hole

Abandoned

Date

JUL 21 1926

CHAS. L. SHERWOOD

192

Scout