


Map No. 15 Sec. 4 Twp. 22 R. 12
 Well No. 5 - Frankhouser Farm
Simmons & Texas Company

NORTH

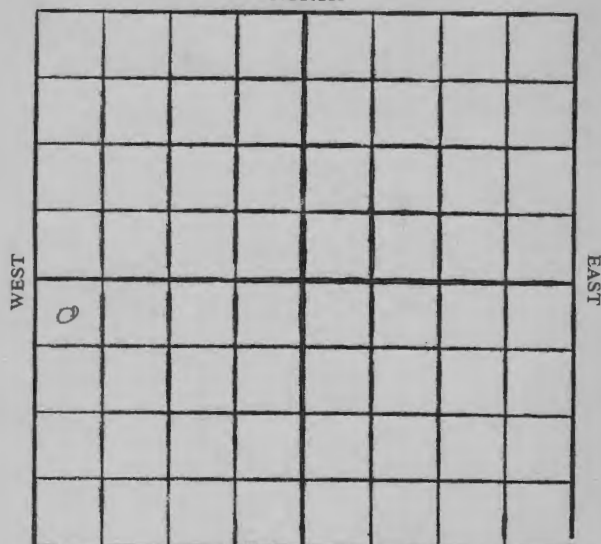

SOUTH

Location _____
 Drilling Remarks _____

Rig Up _____
 Drilling Remarks _____

RECORD


Cased _____ in. _____ ft.
 Sand _____
 Gas _____
 Oil _____
 Total Depth _____

PRODUCTION

1st 24 hrs. Nat. _____
 1st 24 hrs. after shot _____
 Gas _____ cu. ft.
 Dry Hole _____
 Abandoned _____

Map No. 15 Sec. 4 Twp. 22 R. 12
 Well No. 5 - Frankhouser Farm
Simmons & Texas Company

NORTH

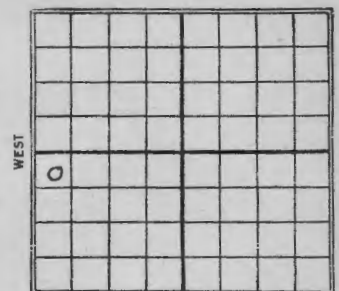

SOUTH

330 Ft. from N. Line

2380 Ft. from S. Line

4904 Ft. from E. Line

330 Ft. from W. Line

Date

REPORT

12/2 Rig up
12/8 Rigging up
12/15 Drlg 225'
12/22 " 575
12/30 " 910
1927
1/6 Drlg 1270
1/13 " 1560
1/19 " 1783
1/25 Sand 1885-1905 T.D.
 shot 80 qts. estimated 30 bbls. (tel)
4/26 Sand 1885-1905
 80/30 bbls

Sherwood
21 KANSAS
 Map No. 5 Sec. 4 Twp. 22 R. 12
 Well No. 5 Frankhousen "C"
Simmons & Texas Company

Contractor

FIRST REPORTS

330 Ft. from N. Line
2380 Ft. from S. Line
4904 Ft. from E. Line
330 Ft. from W. Line

SECTION PLAT

Location ✓
 Rig up ✓
 Drilling and Remarks:

RECORD

Cased in., ft.
 Sand
 Gas
 Oil
 Total Depth

PRODUCTION

1st 24 hrs. Nat.
 1st 24 hrs. after shot
 Gas Cu. Ft.
 Dry Hole
 Abandoned

Date

DEC 2 1926 **CHAS. L. SHERWOOD**
192 Scout

Sherwood
21 KANSAS
 Map No. 5 Sec. 4 Twp. 22 R. 12
 Well No. 5 Frankhousen "C"
Simmons & Texas Company

Contractor

COMPLETED

SECTION PLAT

330 Ft. from N. Line
2380 Ft. from S. Line
4904 Ft. from E. Line
330 Ft. from W. Line

Location Rig up

Drilling and Remarks:

8430 Bls.

RECORD

Cased 1885 in., 1905 ft.
 Sand
 Gas
 Oil
 Total Depth 1905

PRODUCTION

1st 24 hrs. Nat.
 1st 24 hrs. after shot
 Gas Cu. Ft.
 Dry Hole
 Abandoned

Date

JAN 26 1927 **CHAS. L. SHERWOOD**
192 Scout