


Greenwood
 Map No. 15 Sec. 4 Twp. 22 R. 12E
 Well No. 7 - Frankhouser Farm
Fisher & Lauck Company

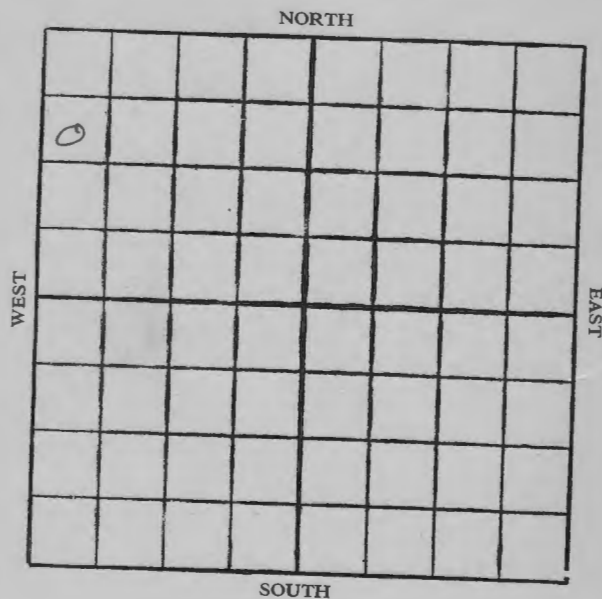

Location
 Drilling Remarks

Rig Up
 Drilling Remarks

RECORD


Cased _____ in. _____ ft.
 Sand _____
 Gas _____
 Oil _____
 Total Depth _____

PRODUCTION

1st 24 hrs. Nat. _____
 1st 24 hrs. after shot _____
 Gas _____ cu. ft.
 Dry Hole _____
 Abandoned _____

Greenwood
 Map No. 15 Sec. 4 Twp. 22 R. 12E
 Well No. 7 - Frankhouser Farm
Fisher & Lauck Company

990 Ft. from N. Line
 _____ Ft. from S. Line
 _____ Ft. from E. Line
330 Ft. from W. Line

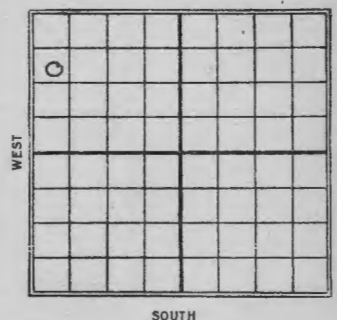

1926

Date

REPORT

12/2 Spudding
 12/8 Drlg 450'
 12/15 " 1842'
 12/22 sand 1895-1938' in sand
 shot 160 qts, 300' oil in hole
 12/30 sand 1895-1938
 160/2 bbls
 J.D. 1938

21 KANSAS

Map No. Sec. 4 Twp. 22 R. 12

Well No. 7 Frankhouser

Fisher & Lauck Company

Contractor

FIRST REPORTS

990 Ft. from N. Line

Ft. from S. Line

Ft. from E. Line

330 Ft. from W. Line

SECTION PLAT

0			

Location

Rig up

Drilling and Remarks:

Spurong

RECORD

Cased in., ft.

Sand

Gas

Oil

Total Depth

PRODUCTION

1st 24 hrs. Nat.

1st 24 hrs. after shot

Gas Cu. Ft.

Dry Hole

Abandoned

Date

DEC 2 1926

CHAS. L. SHERWOOD

192 Scout

21 KANSAS

Map No. Sec. 4 Twp. 22 R. 12

Well No. 7 Frankhouser

Fisher & Lauck Company

Contractor

COMPLETED

SECTION PLAT

990 Ft. from N. Line

Ft. from S. Line

Ft. from E. Line

330 Ft. from W. Line

0			

Location

Rig up

Drilling and Remarks:

1697 lbs.

RECORD

Cased in., ft.

Sand 1895-1938

Gas

Oil

Total Depth 1938

PRODUCTION

1st 24 hrs. Nat.

1st 24 hrs. after shot

Gas Cu. Ft.

Dry Hole

Abandoned

Date

DEC 30 1926

CHAS. L. SHERWOOD

192 Scout