


K21 KANSAS Sec. 4 Twp. 22 R. 12

Well No. 4 Frank Houston
Fisher & Leuck Company
Contractor

FIRST REPORTS

SECTION PLAT

330 3058 Ft. from N. Line
4257 Ft. from S. Line
990 Ft. from E. Line
990 Ft. from W. Line

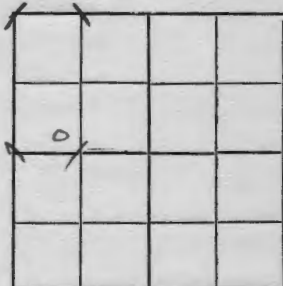

Location
Rig up

Drilling and Remarks:
No. 4

RECORD

Cased in, ft.
Sand
Gas
Oil
Total Depth

PRODUCTION

1st 24 hrs. Nat.
1st 24 hrs. after shot
Gas Cu. Ft.
Dry Hole
Abandoned

Date

JUN 9 1926

CHAS. L. SHERWOOD

192 Scout


K21 KANSAS Sec. 4 Twp. 22 R. 12

Well No. 4 Frank Houston
Fisher & Leuck Company
Contractor

COMPLETED

SECTION PLAT

330 3058 Ft. from N. Line
4257 Ft. from S. Line
990 Ft. from E. Line
990 Ft. from W. Line

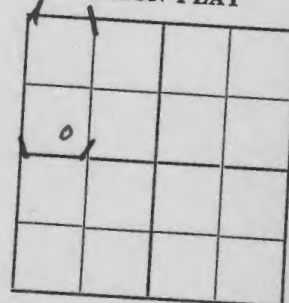

Location

Rig up

Drilling and Remarks:

Sdy shab 1832-57

307 15 B.S.

RECORD

Cased 1857 in., 1867 ft.
Sand
Gas
Oil
Total Depth 1874

PRODUCTION

1st 24 hrs. Nat.
1st 24 hrs. after shot
Gas Cu. Ft.
Dry Hole
Abandoned

Date

JUL 21 1926

CHAS. L. SHERWOOD

192 Scout