Greenwood Co


Form 51—5M—8-26—22544

Map No. Kans. Sec. 4 Twp. 22 R. 12

Well No. 7-"A" Frankhouser Farm

Simmons Etal Company

NORTH

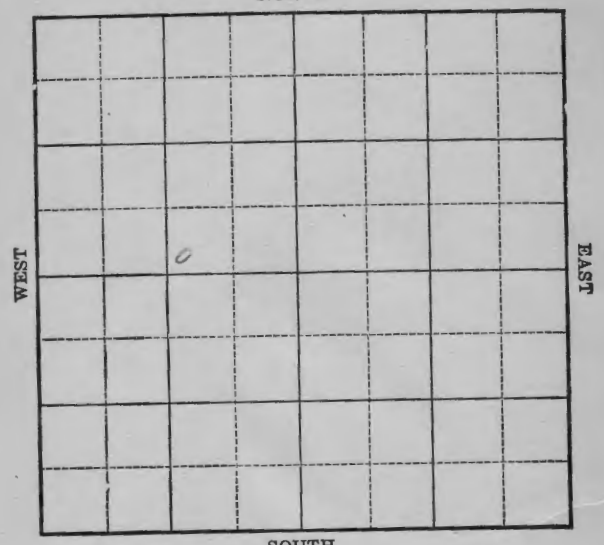

6

Location

Drilling Remarks

Rig Up

Drilling Remarks

RECORD

Cased ____ in. ____ ft.

Sand

Gas

Oil

Total Depth

PRODUCTION

1st 24 hrs. Nat.

1st 24 hrs. after shot

Gas ____ cu. ft.

Dry Hole

Abandoned

Greenwood

Form 252A—5M—11-25—20913

Map No. Kansas Sec. 4 Twp. 22 R. 12

Well No. 7 A Frankhouser Farm


Simmons etal Company

____ Ft. from N. Line

2813
~~330~~ Ft. from S. Line

3648
~~990~~ Ft. from E. Line

____ Ft. from W. Line

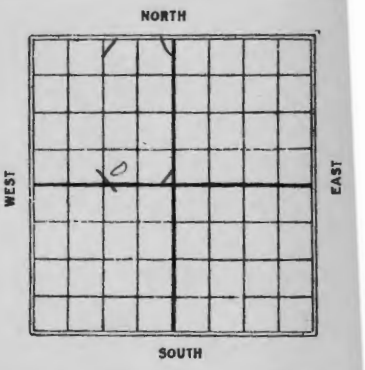

Date	REPORT
~~4/26~~	
4/28	Timbers
5/8	Rig
5/14	Same.
5/19	Spudding
6/2	drlg. 1700'
6/9	Sand 1873-1899
	120 gts 150 bbls

Form 26—1M Bks.—3-23—11959. Greenwood

Map No. K21 KANSAS Sec. 4 Twp. 22 R. 12


Well No. 7 A Franshowden

Simmons et ah Company

Contractor

COMPLETED

SECTION PLAT

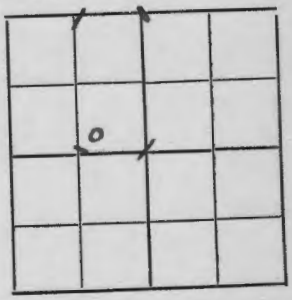

330 2813 Ft. from S. Line

990 3648 Ft. from E. Line

Ft. from N. Line

Ft. from W. Line

Location	RECORD
Rig up	Cased in., ft.
Drilling and Remarks:	Sand 1873-1899
1207/150 lbs	Gas
	Oil
	Total Depth 1899
	PRODUCTION
	1st 24 hrs. Nat.
	1st 24 hrs. after shot
	Gas Cu. Ft.
	Dry Hole
	Abandoned

Date JUN 9 1926

192 CHAS. L. SHERWOOD Scout

Form 26—1M Bks.—3-23—11959. Greenwood


Map No. K21 KANSAS Sec. 4 Twp. 22 R. 12

Well No. 7 A Franshowden

Simmons et ah Company

Contractor

SECTION PLAT

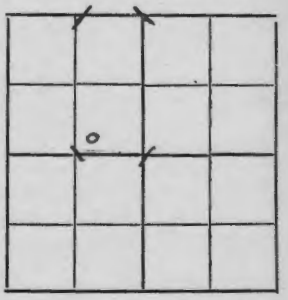

330 2813 Ft. from S. Line

990 3648 Ft. from E. Line

Ft. from N. Line

Ft. from W. Line

FIRST REPORTS

Location	RECORD
Rig up Timbers	Cased in., ft.
Drilling and Remarks:	Sand
	Gas
	Oil
	Total Depth
	PRODUCTION
	1st 24 hrs. Nat.
	1st 24 hrs. after shot
	Gas Cu. Ft.
	Dry Hole
	Abandoned

Date APR 28 1926

192 CHAS. L. SHERWOOD Scout