


Map No. K Sec. 4 Twp. 22 R. 12
Well No. 25 Frankhouser Farm
Simmons et al Company

NORTH

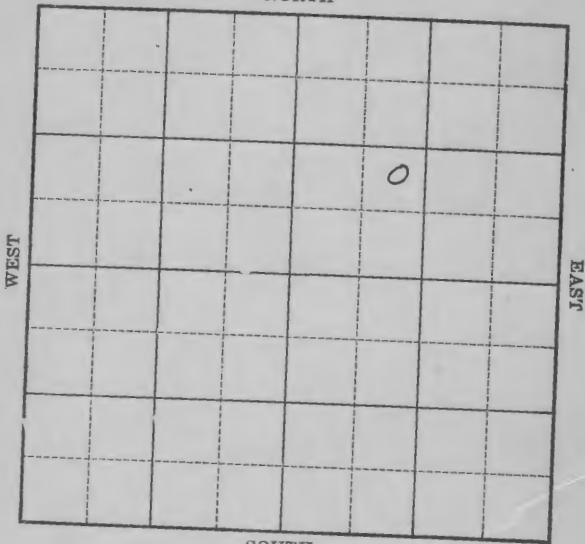

SOUTH

Location _____
Drilling Remarks _____

Rig Up _____
Drilling Remarks _____

RECORD


Cased _____ in. _____ ft.
Sand _____
Gas _____
Oil _____
Total Depth _____

PRODUCTION

1st 24 hrs. Nat. _____
1st 24 hrs. after shot _____
Gas _____ cu. ft.
Dry Hole _____
Abandoned _____

Map No. Kansas Sec. 4 Twp. 22 R. 12
Well No. 25 Frankhouser Farm
Simmons et al Company

NORTH

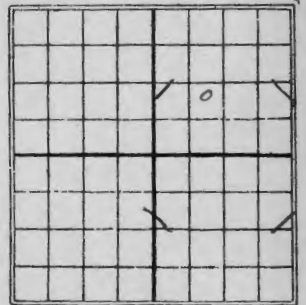

SOUTH

_____ Ft. from N. Line
3738
990 Ft. from S. Line
1640 Ft. from E. Line
990 Ft. from W. Line

Date

REPORT

1926
6/17 R.O.G.
6/25 same
6-30 Ry
7/8 _____
7/15 _____
7/22 dlg 300'
7/28 " 990
8/11 Sand 1801-1840
Oil 1820-80/12.5 bbl
T.D. 1845.

Ardenwood

21 KANSAS Sec. 4 Twp. 22 R. 12

Map No. 2 B Langhousen

Well No. Dimmons et al

Company

Contractor

COMPLETED

SECTION PLAT

990 Ft. from N. Line
163728
990 Ft. from S. Line
1640
990 Ft. from E. Line
990 Ft. from W. Line


Location

Rig up

Drilling and Remarks:

Oct 1820

80y 125 lbs.

RECORD

Cased in., 1840 ft.
Sand 1801-1840
Gas
Oil
Total Depth 1845

PRODUCTION

1st 24 hrs. Nat.
1st 24 hrs. after shot
Gas Cu. Ft.
Dry Hole
Abandoned

Date

AUG 11 1926

CHAS. L. SHERWOOD

192 Scout

Ardenwood

K21 KANSAS Sec. 4 Twp. 22 R. 12

Map No. 2 B Langhousen

Well No. Dimmons et al

Company

Contractor

FIRST REPORTS

SECTION PLAT

990 Ft. from N. Line
3728
990 Ft. from S. Line
1640 Ft. from E. Line
990 Ft. from W. Line


Location

Rig up

Drilling and Remarks:

Bo 4

RECORD

Cased in., ft.
Sand
Gas
Oil
Total Depth

PRODUCTION

1st 24 hrs. Nat.
1st 24 hrs. after shot
Gas Cu. Ft.
Dry Hole
Abandoned

Date

JUN 17 1926

CHAS. L. SHERWOOD

192 Scout