


Greenwood
 Map No. Kansas Sec. 4 Twp. 22 R. 12
 Well No. 3-B Frankhouser Farm
Simmons et al Company

NORTH

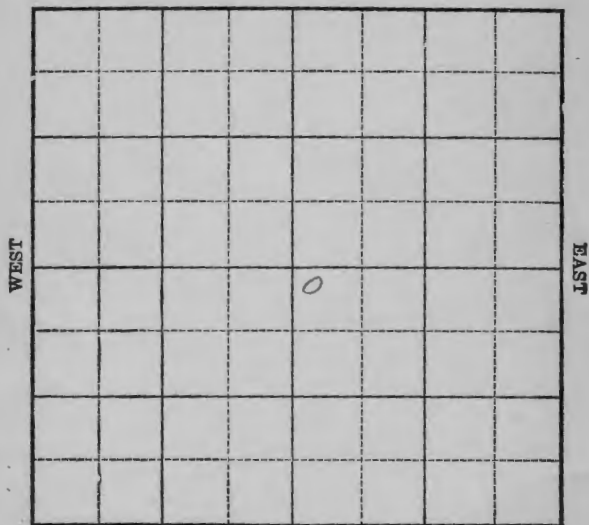

SOUTH

Location _____
 Drilling Remarks _____

Rig Up _____
 Drilling Remarks _____

RECORD


Cased _____ in. _____ ft.
 Sand _____
 Gas _____
 Oil _____
 Total Depth _____

PRODUCTION

1st 24 hrs. Nat. _____
 1st 24 hrs. after shot _____
 Gas _____ cu. ft.
 Dry Hole _____
 Abandoned _____

Greenwood
 Map No. Kansas Sec. 4 Twp. 22 R. 12
 Well No. 3-B Frankhouser Farm
Simmons et al Company

NORTH

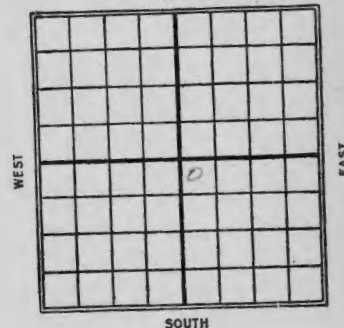

SOUTH

330 Ft. from N. Line
2374 Ft. from S. Line
2288 Ft. from E. Line
330 Ft. from W. Line

Date 1926

REPORT

4/14 Location
4/21 Bldg Rig
4/30 Rign
5/8 Dlg 525'
5/14 " 900'
5/19 Sand 1815-1850'
 J.D. 1852' 16 of 300 B.B.B.

Greenwood
 K21 KANSAS Sec. 4 Twp. 22 R. 12
 Map No. 3 B *Frank Houston*
 Well No. *Hammons et al*

Company

Contractor

FIRST REPORTS

SECTION PLAT

230 Ft. from N. Line
2374 Ft. from S. Line
2288 Ft. from E. Line
330 Ft. from W. Line

		o	

Location ☒

Rig up

Drilling and Remarks:

RECORD

Cased in, ft.

Sand

Gas

Oil

Total Depth

PRODUCTION

1st 24 hrs. Nat.

1st 24 hrs. after shot

Gas Cu. Ft.

Dry Hole

Abandoned

Date

APR 14 1926

192

CHAS. L. SHERWOOD

Scout

Greenwood
 K21 KANSAS Sec. 4 Twp. 22 R. 12
 Map No. 5 B *Frank Houston*
 Well No. *Hammons et al*

Company

Contractor

COMPLETED

SECTION PLAT

230 Ft. from N. Line
2374 Ft. from S. Line
2288 Ft. from E. Line
330 Ft. from W. Line

		o	

Location

Rig up

Drilling and Remarks:

RECORD

Cased in, ft.

Sand *1815-1850*

Gas

Oil

Total Depth *1852*

PRODUCTION

1st 24 hrs. Nat.

1st 24 hrs. after shot

Gas Cu. Ft.

Dry Hole

Abandoned

Date

MAY 19 1926

192

CHAS. L. SHERWOOD


Scout

Sherwood
 Map No. *121* KANSAS Sec. *4* Twp. *22* R. *12*
 Well No. *58* *Franzhausen*
Simmons of *th* Company

Contractor

SECTION PLAT

330 Ft. from N. Line
2374 Ft. from S. Line
2288 Ft. from E. Line
330 Ft. from W. Line

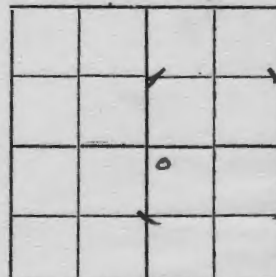

CORRECTION

Location

Rig up

Drilling and Remarks:

*Rigging up**Previously reported**to #38. Chg**to above*

RECORD

Cased in, ft.

Sand

Gas

Oil

Total Depth

PRODUCTION

1st 24 hrs. Nat.

1st 24 hrs. after shot

Gas Cu. Ft.

Dry Hole

Abandoned

Date

APR 28 1976

CHAS. L. SHERWOOD

197

Scout