


Greenwood

Map No. K 98 Sec. 4 Twp. 22 R. 12
 Well No. 158 Frankhouser ^{Unit} Farm
Simmons et al Company

NORTH

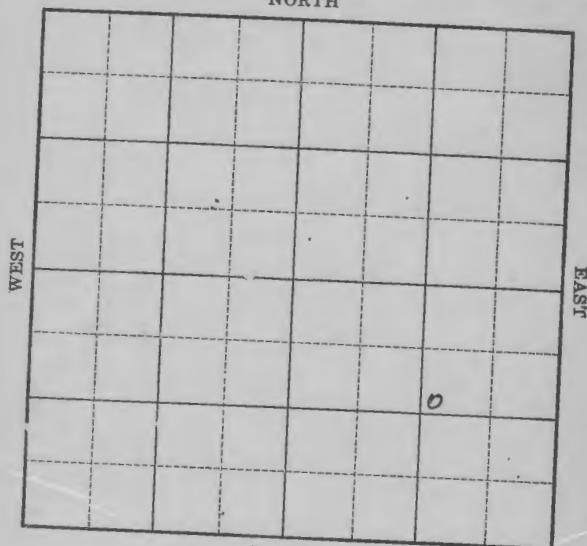

SOUTH

Location _____
 Drilling Remarks _____

Rig Up _____
 Drilling Remarks _____

RECORD

sed _____ in. _____ ft.
 nd _____
 s _____
 al Depth _____


PRODUCTION

1st 24 hrs. Nat. _____
 1st 24 hrs. after shot _____
 Gas _____ cu. ft.
 Dry Hole _____
 Abandoned _____

Greenwood

Map No. K 98 Sec. 4 Twp. 22 R. 12
 Well No. 158 Frankhouser ^{Unit} Farm
Simmons et al Company

NORTH

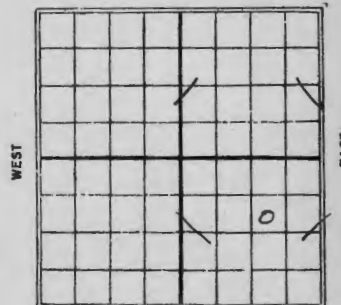

SOUTH

990 Ft. from N. Line1693 Ft. from S. Line979 Ft. from E. Line

_____ Ft. from W. Line

Date

REPORT

19266/24 Rig up6-30 F89 5007/8 Blg 9007/15 " 15607/21 Sand 1803-25, sdy
shale 1770-1803140/200 bbl. T.O. 1829

K21 KANSAS

Map No. Sec. 4 Twp. 22 R. 12

Well No. 15 B Frank Louder Unit

Diamonds et al Company

Contractor

FIRST REPORTS

SECTION PLAT

990 Ft. from N. Line

1623 Ft. from S. Line

990 979 Ft. from E. Line

Ft. from W. Line

Location

Rig up

Drilling and Remarks:

RECORD

Cased in, ft.

Sand

Gas

Oil

Total Depth

PRODUCTION

1st 24 hrs. Nat.

1st 24 hrs. after shot

Gas Cu. Ft.

Dry Hole

Abandoned

Date

JUN 24 1926

CHAS. L. SHERWOOD

192

Scout

K21 KANSAS

Map No. Sec. 4 Twp. 22 R. 12

Well No. 9 B Frank Louder Unit

Diamonds et al Company

Contractor

COMPLETED

SECTION PLAT

990 Ft. from N. Line

1623 Ft. from S. Line

990 979 Ft. from E. Line

Ft. from W. Line

Location

Rig up

Drilling and Remarks:

Sdy Shale 1770
1803

140 200 Bl.

RECORD

Cased in, ft.

Sand 1803-1825

Gas

Oil

Total Depth 1829

PRODUCTION

1st 24 hrs. Nat.

1st 24 hrs. after shot

Gas Cu. Ft.

Dry Hole

Abandoned

Date

JUL 21 1926

CHAS. L. SHERWOOD

192

Scout