


Greenwood ✓
 Map No. 17N Sec. 4 Twp. 22 R. 12
 Well No. 4c Frankhouser Farm
Simmons & Texas Company

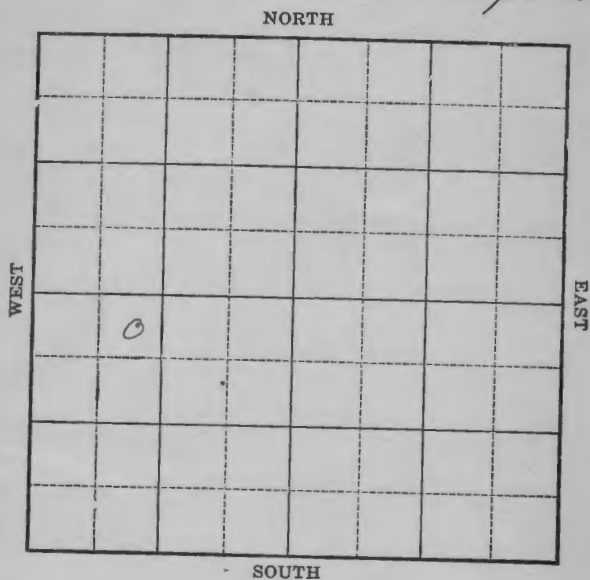

Location _____
 Drilling Remarks _____

Rig Up _____
 Drilling Remarks _____

RECORD


Cased _____ in. _____ ft.
 Sand _____
 Gas _____
 Oil _____
 Total Depth _____

PRODUCTION

1st 24 hrs. Nat. _____
 1st 24 hrs. after shot _____
 Gas _____ cu. ft.
 Dry Hole _____
 Abandoned _____

Greenwood
 Map No. 17N Sec. 4 Twp. 22 R. 12
 Well No. 4c Frankhouser Farm
Simmons & Texas Company

330 Ft. from N. Line
2208 Ft. from S. Line
4085 Ft. from E. Line
990 Ft. from W. Line

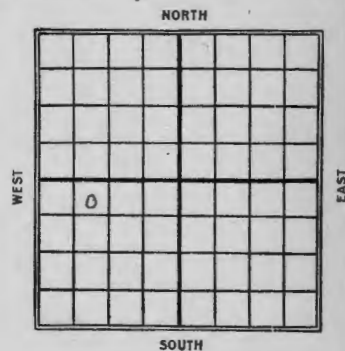

Date

REPORT

8/11 Spudding
 8/18 Dlg 600
 8/25 10" 940'
 8-31 Dlg 1200
 9/15 Sand 1837-1864
 120/60 lbs.

K21 KANSAS

Map No. 4 Sec. 4 Twp. 22 R. 12

Well No. 4 C Frank Houston
Simmons & Texas Company

Contractor

FIRST REPORTS

330 Ft. from N. Line

2208 Ft. from S. Line

4085 Ft. from E. Line

990 Ft. from W. Line

SECTION PLAT

Location -----

Rig up -----

Drilling and Remarks:

Spending

RECORD

Cased ----- in., ----- ft.

Sand -----

Gas -----

Oil -----

Total Depth -----

PRODUCTION

1st 24 hrs. Nat. -----

1st 24 hrs. after shot -----

Gas ----- Cu. Ft.

Dry Hole -----

Abandoned -----

Date

AUG 11 1926 CHAS. L. SHERWOOD
192 Scout

KANSAS Map No. 21 Sec. 4 Twp. 22 R. 12

Well No. 4 C Frank Houston
Simmons & Texas Company

Contractor

COMPLETED

SECTION PLAT

330 Ft. from N. Line

2208 Ft. from S. Line

4085 Ft. from E. Line

990 Ft. from W. Line

Location -----

Rig up -----

Drilling and Remarks:

120 60 ft

RECORD

Cased ----- in., ----- ft.

Sand 1837-1864

Gas -----

Oil -----

Total Depth 1864

PRODUCTION

1st 24 hrs. Nat. -----

1st 24 hrs. after shot -----

Gas ----- Cu. Ft.

Dry Hole -----

Abandoned -----

Date

SEP 15 1926 CHAS. L. SHERWOOD
192 Scout