


Map No. 15ans Sec. 9 Twp. 22 R. 12
 Well No. 1 Holderman Farm
Texas Co. Company

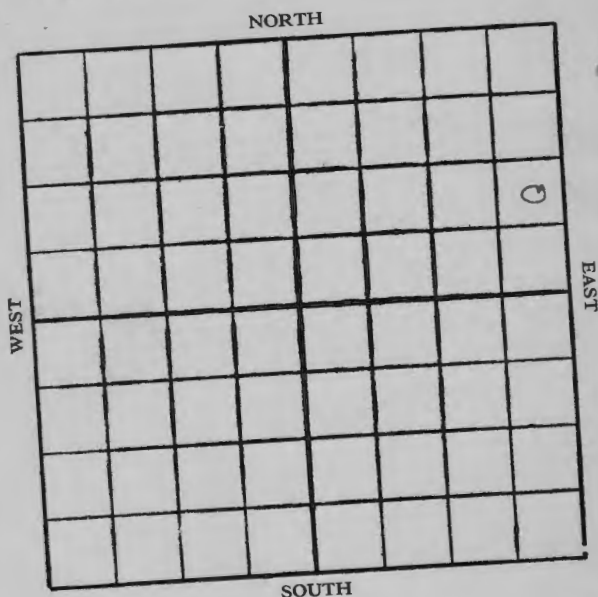

Location
 Drilling Remarks

Rig Up.....
 Drilling Remarks

RECORD

Cased.....in.ft.
 Sand
 Gas
 Oil
 Total Depth.....

PRODUCTION

1st 24 hrs. Nat.....
 1st 24 hrs. after shot.....
 Gas.....cu. ft.
 Dry Hole.....
 Abandoned.....

Map No. 15ans Sec. 9 Twp. 22 R. 1
 Well No. 1 Holderman
Texas Co. Company

Ft. from N. Line

990 3611

Ft. from S. Line

330 326

Ft. from E. Line

Ft. from W. Line

1926

Date

REPORT

10/27 Bldg rig
 11/11 Drld 395'
 11/17 " 1050'
 11/23 " 1725'
 12/2 Sand 1795-1828
 60/152 bbls
 Total depth 1831

21 KANSAS
 Map No. _____ Sec. 9 Twp. 22 R. 12
 Well No. 1 Holderman
 Texas Co. Company

Contractor

FIRST REPORTS

SECTION PLAT

_____ Ft. from N. Line
 990 3611
 _____ Ft. from S. Line
 370 326
 _____ Ft. from E. Line
 _____ Ft. from W. Line

Location Blogg
 Rig up
 Drilling and Remarks:

RECORD

Cased _____ in., _____ ft.
 Sand _____
 Gas _____
 Oil _____
 Total Depth _____

PRODUCTION

1st 24 hrs. Nat. _____
 1st 24 hrs. after shot _____
 Gas _____ Cu. Ft.
 Dry Hole _____
 Abandoned _____

1926

CHAS. L. SHERWOOD

192

Scout

21 KANSAS
 Map No. _____ Sec. 9 Twp. 22 R. 12
 Well No. 1 Holderman
 Texas Co. Company

Contractor

COMPLETED

SECTION PLAT

_____ Ft. from N. Line
 990 3611
 _____ Ft. from S. Line
 330 326
 _____ Ft. from E. Line
 _____ Ft. from W. Line

Location _____
 Rig up _____
 Drilling and Remarks:

RECORD

Cased _____ in., _____ ft.
 Sand 1795-1878
 Gas _____
 Oil _____
 Total Depth 1831

PRODUCTION

1st 24 hrs. Nat. _____
 1st 24 hrs. after shot _____
 Gas _____ Cu. Ft.
 Dry Hole _____
 Abandoned _____

2 1926

CHAS. L. SHERWOOD

192

Scout