


Greenwood
 Map No. KANS Sec. 9 Twp. 22 R. 12
 Well No. 1 Holderman Farm
C. W. Titus Company

NORTH

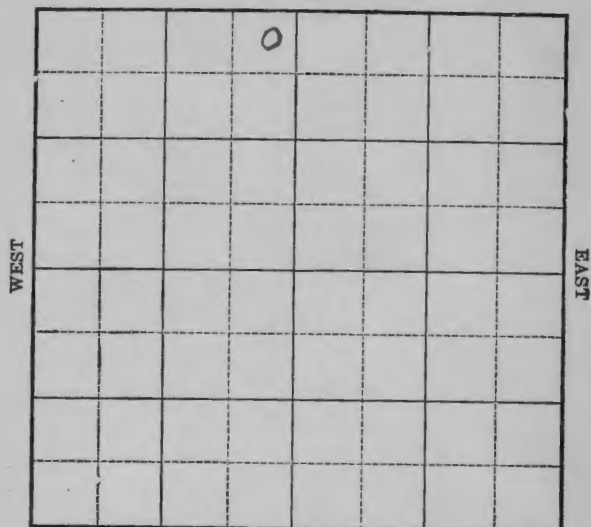

SOUTH

Location _____
 Drilling Remarks _____

Rig Up _____
 Drilling Remarks _____

RECORD

Cased _____ in. _____ ft.
 Sand _____
 Gas _____
 Oil _____
 Total Depth _____

PRODUCTION

1st 24 hrs. Nat. _____
 1st 24 hrs. after shot _____
 Gas _____ cu. ft.
 Dry Hole _____
 Abandoned _____

Greenwood
 Map No. Kansas Sec. 9 Twp. 22 R. 12
 Well No. 1 Holderman Farm
C. W. Titus Company

NORTH


320 Ft. from N. Line

4918 Ft. from S. Line

2928
33 Ft. from E. Line

_____ Ft. from W. Line

WEST

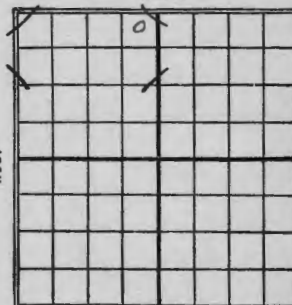

SOUTH

Offsh

Date

REPORT

1936

6/30

Rig up

7/8

7/15

7/22

7/28

8/4

8/11

8/18

8/25

9/3

9/15

8/25

8/25

T.D. 1828 300 ft oil in hole

S.D. for order (2nd)

8/25 shot 120 gts 800' oil in
 Rob. cleaning out

9/15 sand 1800-1828
 100/50 bbls.

K21 KANSAS

Map No. Sec. 9 Twp. 22 R. 12

Well No. 1 Holderman
C. H. Titus Company

Contractor

FIRST REPORTS


330 Ft. from N. Line

4918 Ft. from S. Line

330 2928 Ft. from E. Line

Ft. from W. Line

SECTION PLAT

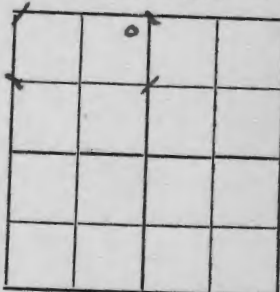

Location

Rig up

Drilling and Remarks:

RECORD

Cased in, ft.

Sand

Gas

Oil

Total Depth

PRODUCTION

1st 24 hrs. Nat.

1st 24 hrs. after shot

Gas Cu. Ft.

Dry Hole

Abandoned

Date

JUN 30 1926

CHAS. L. SHERWOOD

192 Scout

K21 KANSAS Sec. 9 Twp. 22 R. 12

Well No. 1 Holderman
C. H. Titus Company

Contractor

COMPLETED


330 Ft. from N. Line

4918 Ft. from S. Line

330 2928 Ft. from E. Line

Ft. from W. Line

SECTION PLAT

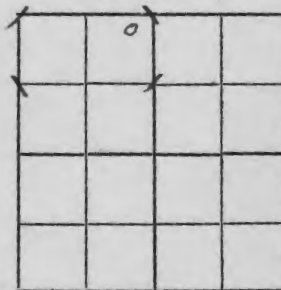

Location

Rig up

Drilling and Remarks:

RECORD

Cased in, ft.

Sand 1800-1828

Gas

Oil

Total Depth 1828

PRODUCTION

1st 24 hrs. Nat.

1st 24 hrs. after shot

Gas Cu. Ft.

Dry Hole

Abandoned

Date

SEP 15 1926

CHAS. L. SHERWOOD

192 Scout