


*Greenwood*

Map No. *1* Sec. *9* Twp. *22* R. *12*  
 Well No. *Holderman* Farm  
*Simmons etal* Company

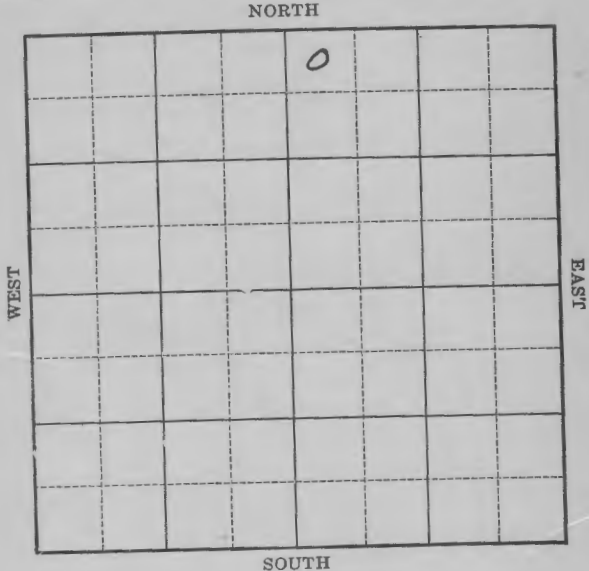

Location \_\_\_\_\_  
 Drilling Remarks \_\_\_\_\_

Rig Up \_\_\_\_\_  
 Drilling Remarks \_\_\_\_\_

**RECORD**

Cased \_\_\_\_\_ in. \_\_\_\_\_ ft.  
 Sand \_\_\_\_\_  
 Gas \_\_\_\_\_  
 Oil \_\_\_\_\_  
 Total Depth \_\_\_\_\_


**PRODUCTION**

1st 24 hrs. Nat. \_\_\_\_\_  
 1st 24 hrs. after shot \_\_\_\_\_  
 Gas \_\_\_\_\_ cu. ft.  
 Dry Hole \_\_\_\_\_  
 Abandoned \_\_\_\_\_

*Greenwood*

Map No. *Kansas* Sec. *9* Twp. *22* R. *12*  
 Well No. *1 Holderman* Far  
*Simmons etal* Compar

*220* Ft. from N. Line  
*4920* Ft. from S. Line  
*2278* Ft. from E. Line  
*230* Ft. from W. Line

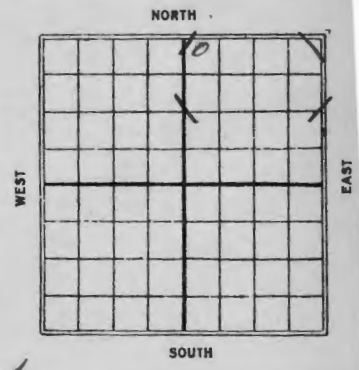

*Offset*

Date	REPORT
1926	
6/17	R.O.G.
6/25	same
6-30	kg
7/18	
7/15	Dlg 800
7/23	Set 6' 1751 Sandy shale 1751-79 Btn sand 1779-1824 T.D. 1828 in shale filled 300 ft oil in 6 hours Shot 180 gts Bridged Clearing out (2nd)
7/28	Broken sand 1779-1824 Sdy shale 1751-79 160/75 bbls. T.D. 1828 in shale

*Sherwood*

K21 KANSAS Map No. Sec. 9 Twp. 22 R. 12

Well No. 1 *Holderman*  
*Simmons et al* Company

Contractor

FIRST REPORTS

SECTION PLAT

*330* Ft. from N. Line  
*4920* Ft. from S. Line  
*2278* Ft. from E. Line  
*330* Ft. from W. Line

		o	

*OFFSET*

Location \_\_\_\_\_  
Rig up \_\_\_\_\_  
Drilling and Remarks:

*KO 8*

RECORD  
Cased \_\_\_\_\_ in., \_\_\_\_\_ ft.  
Sand \_\_\_\_\_  
Gas \_\_\_\_\_  
Oil \_\_\_\_\_  
Total Depth \_\_\_\_\_

PRODUCTION  
1st 24 hrs. Nat. \_\_\_\_\_  
1st 24 hrs. after shot \_\_\_\_\_  
Gas \_\_\_\_\_ Cu. Ft.  
Dry Hole \_\_\_\_\_  
Abandoned \_\_\_\_\_

Date

JUN 17 1926

192 CHAS. L. SHERWOOD Scout

*Sherwood*

K21 KANSAS Map No. Sec. 9 Twp. 22 R. 12

Well No. 1 *Holderman*  
*Simmons et al* Company

Contractor

COMPLETED

SECTION PLAT

*330* Ft. from N. Line  
*4920* Ft. from S. Line  
*2278* Ft. from E. Line  
*330* Ft. from W. Line

		o	

*offset*

Location *Bogey* \_\_\_\_\_  
Rig up \_\_\_\_\_  
Drilling and Remarks:

*dry hole 175179*

*16975 lbs.*

RECORD  
Cased \_\_\_\_\_ in., \_\_\_\_\_ ft.  
Sand *1779-1824*  
Gas \_\_\_\_\_  
Oil \_\_\_\_\_  
Total Depth *1828 shot*

PRODUCTION  
1st 24 hrs. Nat. \_\_\_\_\_  
1st 24 hrs. after shot \_\_\_\_\_  
Gas \_\_\_\_\_ Cu. Ft.  
Dry Hole \_\_\_\_\_  
Abandoned \_\_\_\_\_

Date

JUL 28 1926

192 CHAS. L. SHERWOOD Scout