


Greenwood
 Map No. *KANS* Sec. *9* Twp. *22* R. *12*
 Well No. *3* *Holderman* Farm
Simmons et al Company

NORTH

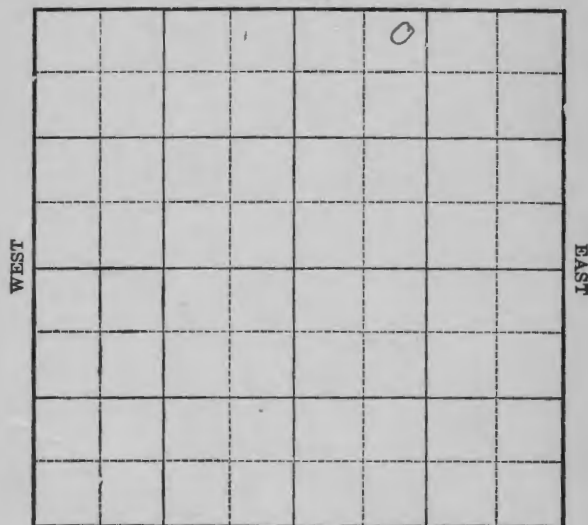

SOUTH

Location _____
 Drilling Remarks _____

Rig Up _____
 Drilling Remarks _____

RECORD

Cased _____ in. _____ ft.
 Sand _____
 Gas _____
 Oil _____
 Total Depth _____


PRODUCTION

1st 24 hrs. Nat. _____
 1st 24 hrs. after shot _____
 Gas _____ cu. ft.
 Dry Hole _____
 Abandoned _____

Greenwood
 Map No. *Kansas* Sec. *9* Twp. *22* R. *12*
 Well No. *3* *Holderman* Farm
Simmons et al Company

NORTH

330 Ft. from N. Line
492 Ft. from S. Line
1627 Ft. from E. Line
990 Ft. from W. Line

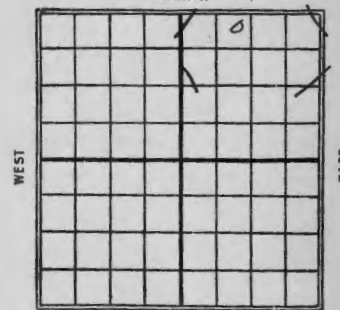

SOUTH

Date

REPORT

1926
6/30 Spudding
7/8
7/15 Running 8" 1396
7/21 Sand 1795-1824
140/100 bbls. T.D. 1824

K21 KANSAS Sec. 9 Twp. 22 R. 12
 Map No. 3 Holderman
 Well No. 3 Holderman
 Simmons et al Company

Contractor

FIRST REPORTS

SECTION PLAT

330 Ft. from N. Line
 492 Ft. from S. Line
 1627 Ft. from E. Line
 990 Ft. from W. Line

Location _____
 Rig up _____
 Drilling and Remarks:

Spudding

RECORD
 Cased _____ in., _____ ft.
 Sand _____
 Gas _____
 Oil _____
 Total Depth _____

PRODUCTION
 1st 24 hrs. Nat. _____
 1st 24 hrs. after shot _____
 Gas _____ Cu. Ft.
 Dry Hole _____
 Abandoned _____

Date

JUN 30 1926

CHAS. L. SHERWOOD

192

Scout

K21 KANSAS Sec. 9 Twp. 22 R. 12
 Map No. 3 Holderman
 Well No. 3 Holderman
 Simmons et al Company

Contractor

COMPLETED

SECTION PLAT

330 Ft. from N. Line
 492 Ft. from S. Line
 1627 Ft. from E. Line
 990 Ft. from W. Line

Location _____
 Rig up _____
 Drilling and Remarks:

140 100 PS

RECORD
 Cased _____ in., _____ ft.
 Sand 1795-1824
 Gas _____
 Oil _____
 Total Depth 1824

PRODUCTION
 1st 24 hrs. Nat. _____
 1st 24 hrs. after shot _____
 Gas _____ Cu. Ft.
 Dry Hole _____
 Abandoned _____

Date

JUL 21 1926

CHAS. L. SHERWOOD

192

Scout