

Map No. K5 Sec. 9 Twp. 22 R. 12
 Well No. 3-Holderman Farm
Texas Co. Company

Ft. from N. Line


330 2954

Ft. from S. Line

330 327

Ft. from E. Line

Ft. from W. Line

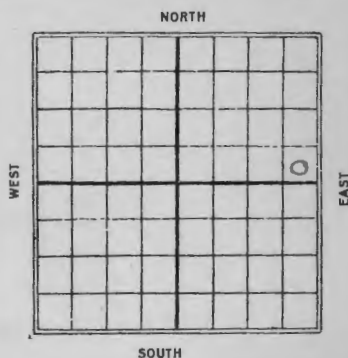

1926

Date

REPORT

12/22 Timber

12/30 Rig


1927 Same

1/13 Drlg 480

1/19 " 1150

1/26 Topsand 1795-1837 T.D. 1841
filled up 400' while drlg. in
will shoot-2/3 Sand 1795-1837
60/120 bbl

Map No. K5 Sec. 9 Twp. 22 R. 12
 Well No. 3-Holderman Farm
Texas Co. Company

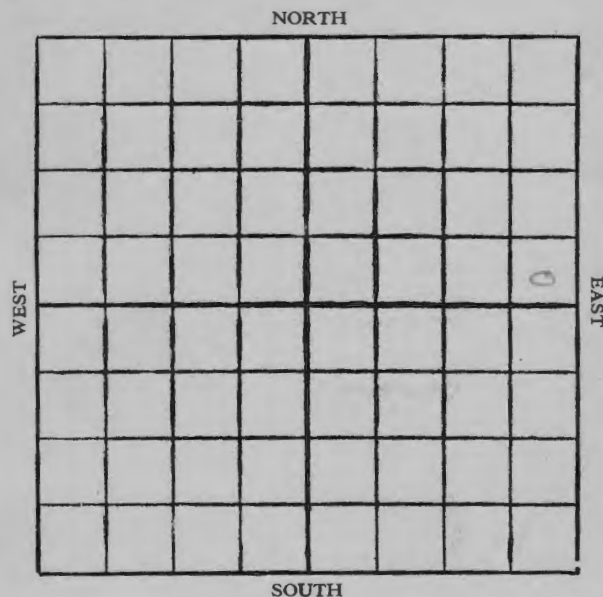
 Location
 Drilling Remarks

 Rig Up
 Drilling Remarks

RECORD

 Cased in. ft.
 Sand
 Gas
 Oil
 Total Depth

PRODUCTION

 1st 24 hrs. Nat.
 1st 24 hrs. after shot
 Gas cu. ft.
 Dry Hole
 Abandoned

21 **KANSAS** Greenwood
 Map No. 9 Sec. 9 Twp. 22 R. 12
 Well No. 3 *Holderman*
Lexas Co.
 _____ Company
 _____ Contractor

FIRST REPORTS

SECTION PLAT

_____ Ft. from N. Line
 330 2954
 _____ Ft. from S. Line
 330 327
 _____ Ft. from E. Line
 _____ Ft. from W. Line

Location _____
 Rig up *Timbers*
 Drilling and Remarks:

RECORD

Cased _____ in., _____ ft.
 Sand _____
 Gas _____
 Oil _____
 Total Depth _____

PRODUCTION

1st 24 hrs. Nat. _____
 1st 24 hrs. after shot _____
 Gas _____ Cu. Ft.
 Dry Hole _____
 Abandoned _____

Date

DEC 22 1926

CHAS. L. SHERWOOD

192

Scout

21 **KANSAS** Greenwood
 Map No. 9 Sec. 9 Twp. 22 R. 12
 Well No. 3 *Holderman*
Lexas Co.
 _____ Company
 _____ Contractor

COMPLETED

SECTION PLAT

_____ Ft. from N. Line
 330 2954
 _____ Ft. from S. Line
 330 327
 _____ Ft. from E. Line
 _____ Ft. from W. Line

Location _____
 Rig up _____
 Drilling and Remarks:

RECORD

Cased _____ in., _____ ft.
 Sand 1795-1837
 Gas _____
 Oil _____
 Total Depth 1841

PRODUCTION

1st 24 hrs. Nat. _____
 1st 24 hrs. after shot _____
 Gas _____ Cu. Ft.
 Dry Hole _____
 Abandoned _____

Date

DEC 3 1927

CHAS. L. SHERWOOD

192

Scout