


Kansas

Map No. Sec. 9 Twp. 22 R. 12
Well No. 4 - Holderman Farm
Texas Co. Company

NORTH

2953
330
x
990
982

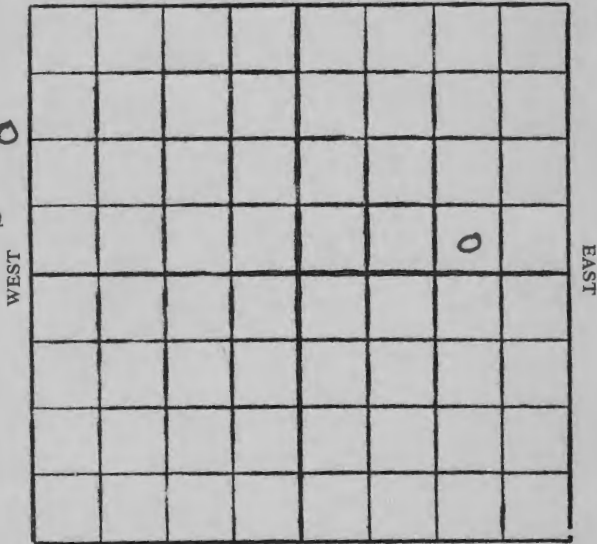


SOUTH

Kansas

Map No. Sec. 9 Twp. 22 R. 12
Well No. 4 - Holderman Farm
Texas Co. Company

NORTH

Ft. from N. Line
330 2953 Ft. from S. Line
990 982 Ft. from E. Line
Ft. from W. Line

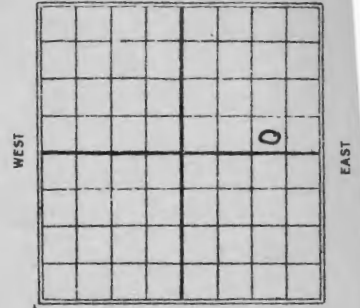

1927

Date REPORT

2/17 R.O.G.
2/24 Bldg rig
3/2 Rigging up
3/9 Drleg 840
3/16 " 1600
3/24 sand 1797-1815
60/20 bbls
T.D. 1818'

Location
Drilling Remarks

Rig Up
Drilling Remarks

RECORD

PRODUCTION

Cased in ft.
Sand
Gas
Oil
Total Depth

1st 24 hrs. Nat.
1st 24 hrs. after shot
Gas cu. ft.
Dry Hole
Abandoned

21 KANSAS
Map No. Sec. 9 Twp. 22 R. 12

Well No. 4 Holderman
Texas Co
Company
Contractor

FIRST REPORTS

Ft. from N. Line
230 2953
Ft. from S. Line
990 982
Ft. from E. Line
Ft. from W. Line

SECTION PLAT

Location
R. 4
Rig up
Drilling and Remarks:

RECORD
Cased _____ in., _____ ft.
Sand _____
Gas _____
Oil _____
Total Depth _____

PRODUCTION
1st 24 hrs. Nat. _____
1st 24 hrs. after shot _____
Gas _____ Cu. Ft.
Dry Hole _____
Abandoned _____

Date
FEB 16 1927
192
CHAS. L. SHERWOOD
Scout

21 KANSAS
Map No. Sec. 9 Twp. 22 R. 12

Well No. 4 Holderman
Texas Co
Company
Contractor

COMPLETED

Ft. from N. Line
230 2953
Ft. from S. Line
990 982
Ft. from E. Line
Ft. from W. Line

SECTION PLAT

Location
Rig up
Drilling and Remarks:

607 20 lbs

RECORD
Cased _____ in., _____ ft.
Sand 1797-1815
Gas _____
Oil _____
Total Depth 1818

PRODUCTION
1st 24 hrs. Nat. _____
1st 24 hrs. after shot _____
Gas _____ Cu. Ft.
Dry Hole _____
Abandoned _____

Date
MAR 24 1927
192
CHAS. L. SHERWOOD
Scout