


Section 9 Township 22 Range 12E ✓

Well No. #1 Luthi

Company Louise Gary

NORTH

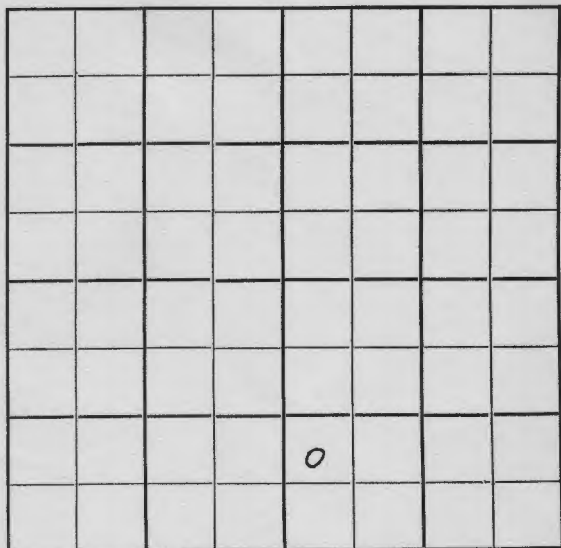

SOUTH

Sec. 9 Twp. 22 R. 12E ✓

Well No. #1 Luthi Farm

Louise Gary Company

Contractor

Wildcat

Ft. from N. Line

984

990'

Ft. from S. Line


2307

Ft. from E. Line

330'

Ft. from W. Line

NORTH

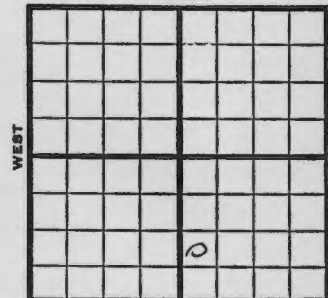

SOUTH

NW SW SE

1951

REPORT

2/7

Spud 2-5-51
Drlg.

3/14

Spud 2-5-51
D & A TD 1951'
10" @ 875, 7" @ 1200,
Burgess 1865, Miss. 1895,
TD 1951' D & A

ABANDONED

