


Greenwood

Map No. *MAN* Sec. *9* Twp. *22* R. *12*

Well No. *7 - Holderman* Farm

Simmons et al Company

NORTH

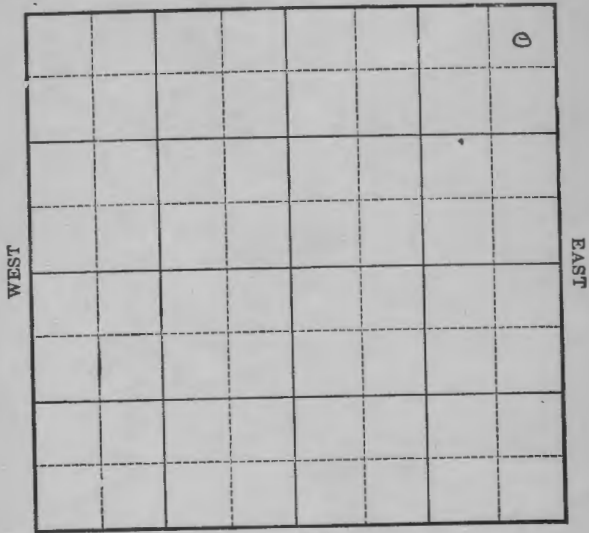

SOUTH

Location _____
Drilling Remarks _____

Rig Up _____
Drilling Remarks _____

RECORD

Cased _____ in. _____ ft.
Sand _____
Gas _____
Oil _____
Total Depth _____

PRODUCTION

1st 24 hrs. Nat. _____
1st 24 hrs. after shot _____
Gas _____ cu. ft.
Dry Hole _____
Abandoned _____

Greenwood

Map No. *MAN* Sec. *9* Twp. *22* R. *12*

Well No. *7 Holderman* Farm

Simmons et al Company


NORTH

330 Ft. from N. Line

4924 Ft. from S. Line

325
330 Ft. from E. Line

_____ Ft. from W. Line

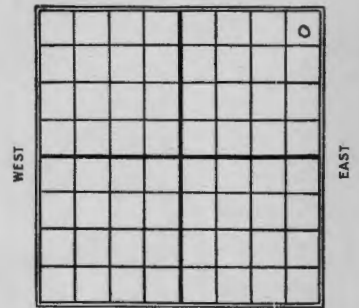

SOUTH

1926

Date

REPORT

8/11 Rig up.
8/18 Dlg 240
8-25 10" 905
8-31 Dlg 1650
9/15 Sand 1820-1840
60/140 bbls

K21 KANSAS
Map No. _____ Sec. 9 Twp. 22 R. 12

Well No. 7
Holdeman
Dunmons & et al Company

Contractor _____

FIRST REPORTS

330 Ft. from N. Line
4924 Ft. from S. Line
330 325 Ft. from E. Line
_____ Ft. from W. Line

SECTION PLAT

			0

Location _____
Rig up _____
Drilling and Remarks:

RECORD
Cased _____ in., _____ ft.
Sand _____
Gas _____
Oil _____
Total Depth _____

PRODUCTION
1st 24 hrs. Nat. _____
1st 24 hrs. after shot _____
Gas _____ Cu. Ft.
Dry Hole _____
Abandoned _____

Date AUG 11 1926
CHAS. L. SHERWOOD
192 _____ Scout

KANSAS
Map No. _____ Sec. 19 Twp. 22 R. 12

Well No. 7
Holdeman
Dunmons & et al Company

Contractor _____

COMPLETED

330 Ft. from N. Line
4924 Ft. from S. Line
330 325 Ft. from E. Line
_____ Ft. from W. Line

SECTION PLAT

			0

Location _____
Rig up _____
Drilling and Remarks:

RECORD
Cased _____ in., _____ ft.
Sand 1820-1840
Gas _____
Oil _____
Total Depth 1840

PRODUCTION
1st 24 hrs. Nat. _____
1st 24 hrs. after shot _____
Gas _____ Cu. Ft.
Dry Hole _____
Abandoned _____

Date SEP 15 1926
CHAS. L. SHERWOOD
192 _____ Scout