


Section 9 Township 22 Range 12E

Well No. #1 Swanson

Company Glenwood Oil

NORTH

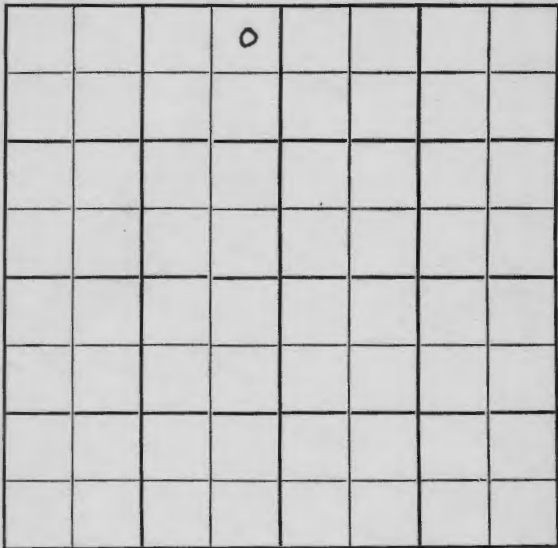

SOUTH

Sec. 9 Twp. 22 R. 12E

Well No. #1 Swanson Farm

Glenwood Oil Company

Marro-Contr. Contractor

960' Ft. from N. Line

4918 Ft. from S. Line


2928 Ft. from E. Line

330' Ft. from W. Line

Ft. from W. Line

NE NE NW

NORTH

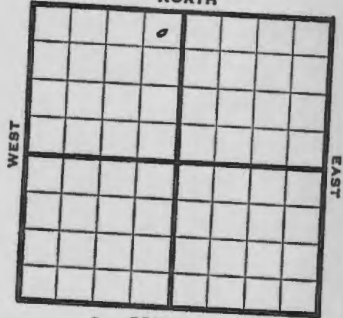

SOUTH

1950 Elv. - REPORT

12/6 7" @ 90'  
Drlg. 859'

1951  
1/10 Oil Well TD 1842  
7" @ 90' Bart 1804 TD 1842  
4" @ 1804 Comp. 15 bopd

COMPLETED

