


Section 12 Township 22 Range 3 E

Well No. # 1 Reigle

Company Aladdin Petroleum

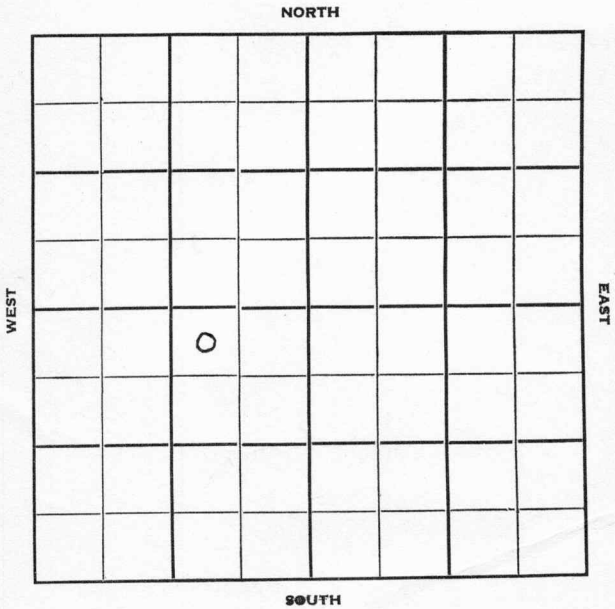

Marion

KANSAS O.W.W.O.

Sec. 12 Twp. 22 R. 3 E

Well No. # 1 Reigle Farm _____

Aladdin Petroleum Company

Contractor _____

Wildcat


330 Ft. from N. Line

_____ Ft. from S. Line

990 Ft. from E. Line

_____ Ft. from W. Line

NW NE SW

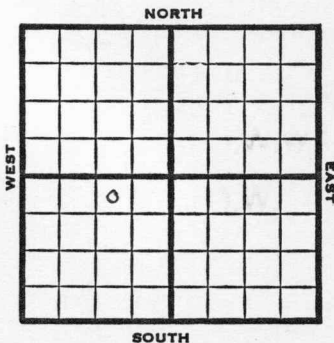

1951 Elev. 1403' REPORT

5/23 R U R

8/15 D&A TD 2970
8-5/8" @ 96'
Br Lime 1855 Lans. 1906
KC 2100
DST 2314-74 opn 1 1/2 hr.
Rec. 25' socm Miss 2459
DST 2454-83 opn 1/2 hr. Rec. 55' oil
240' hocm 60' sw Kh 2607 Hunton 2732
Maq sh 2766 Viola 2791
Simp 2885 Arb. 2936
TD 2970 5" @ 2970
16/2468-73 S/135 bf 7 hr. 25 was oil
36/2448-60 S/171 bf 9hr 17 1/2 was oil
SP 2464 S/175 bf 8 hr. 3 1/2 was oil
SP 2454 CO to 2533 20/2447-52
500 A S/wtr & SSO S/540 bfph 17
was oil PB 2453 D&A

ABANDONED

O.W.W.O.

1951
10/3 Lans. 1906' KC 2100' Marm. 2318'
Burgess 2451' Miss 2459'
OTD 2970' 5" @ 2570'
To work over.

OVER

1951

Information continued

10/17

D&A TD 2452

Lans. 1906

Burgees 2451

KC 2100

Miss 2459

Marm. 2318

OTD 2970

5" @ 2570 CO to 2970

27/ 2470-73 S/ 10 GW 8 BOPH

300 A S/ all wtr. SSO PB 2452

16/ 2447-51 300A

D&A

ABANDONED

County **Marion** State **Kansas**

Sec. **12** (Blk.) **22** (Sur.) **3E** Map No.

Operator **Aladdin Petroleum**

Well No. **1** Farm **Reigle**

Elev. Location **NW NE SW**

FIRST REPORT																							
												0											

330 Ft. From **N** Line **SW**

990 Ft. From **E** Line Quarter

1st. Report **MAY 23 1951**

Completion

Remarks

Spudding Date

Drlg. Data **Wildcat**

RUR

J. E. TYRA

Scout Cards *mm*
Land Small Map
Land Wall Map *3*
Tracings
France Map
Pierce Map
Misc.

MAY 25 1951

Orig. Data

Scout Cards

Land Small Map

Land Wall Map

Tracings

France Map

Pierce Map

Misc.

~~AUG 27 1951~~

3

Scout Cards	mm
Land Small Map	
Land Wall Map	32
Tracings	
France Map	
Pierce Map	
Misc.	

OCT 5 1951

Orig. Data

Scout Cards	my
Land Small Map	
and Wall Map	BP
Tracings	
France Map	
Pierce Map	
Misc.	

OCT 31 1951