


Section 12 Township 22 Range 3 E

Well No. # 1 Stucky

Company Rex & Morris

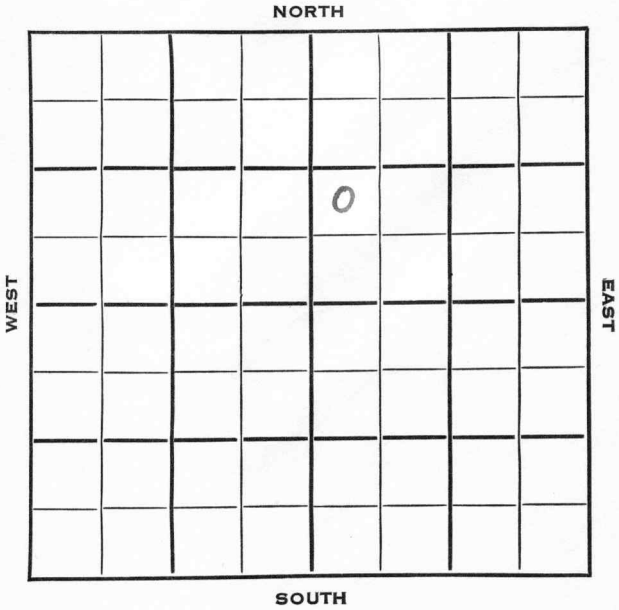

Marion

KANSAS

SEC.	TWP.	R.
12	22	3 E

WELL NO.

1 Stucky

FARM

COMPANY

Rex & Morris

CONTRACTOR

Rex & Morris

Shank Pool

Ft. from N. Line

990


Ft. from S. Line

Ft. from E. Line

330

Ft. from W. Line

NW SW NE

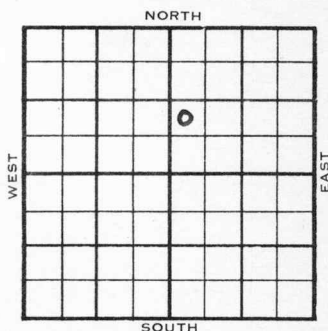

1953

ELEVATION

1429'

REPORT

10/14

Spud 10-15-53

8" @ 94

Drlg. 1445'

10/28

Spud 10-11-53 D & A TD 2524

8" @ 94 B KC 2290 Cong. 2463'

TD 2508'

DST 2470-2508 open 1 hr rec 140' OCM

615# 5" @ 2483 CO to 2508'

56 GO 600 GW 19 hr. DD 2524

59 GO 650 GW Miss 2521'

D & A

ABANDONED

County

Marion

State

Kansas

Sec.

12

(Blk.)
(Twp.)

22

(Sur.)
(Rge.)

3E

Map No.

Operator

Rex & Morris

Well No.

1

Farm

Stucky

Elev.

Location

NW SW NE

0

FIRST REPORT

990 Ft. From

2

Line

NE

330 Ft. From

7

Line

Quarter

1st. Report

OCT

14

53

Completion

Remarks

Rex & Morris

- Contr.

Spudding Date


10-11-53

Drlg. Data

Shank Pool

8" @ 94 drlg. 1445

County Merion State Kansas
 Sec. 12 (Blk. 22 (Sur. 3E Map No.
 (Twp.) (Rge.)
 Operator Rex & Morris
 Well No. 1 Farm Stucky
 Elev. 1429 Location NW SW NE

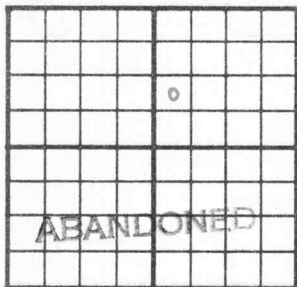

990 Ft. From S Line NE
330 Ft. From W Line Quarter

1st. Report

Completion OCT 28 1953

Remarks Shank Pool

Rex & Morris - Contr.

Spudding Date 10-11-53

Drig. Data D & A TD 2524

8" @ 94 B KC 2290 Cong. 2463

TD 2508 DST 2470-2508 open 1 hr.

Rec. 140' ocm 615# 5" @ 2483

CO to 2508 56 go 600 gw 19 hr.

DD 2524 59 go 650 gw Miss. 2521

D & A