


Map No. _____ Sec. 12 Twp. 22 R. 9
Well No. 1 - Evans Farm _____
Basom et al Company _____

NORTH

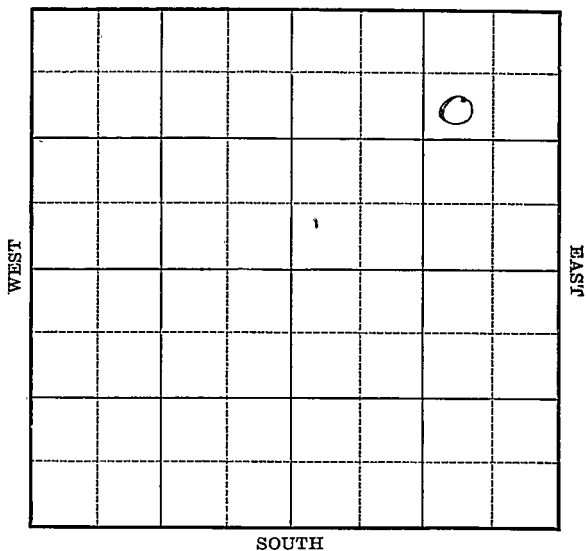

Location_____

Drilling Remarks

Rig Up

Drilling Remarks

RECORD

Cased in. ft.

Sand

Gas

Oil _____

Total Depth_____

PRODUCTION

1st 24 hrs. Nat. _____

1st 24 hrs. after shot_____

Gas _____ cu. ft.

Dry Hole_____

Abandoned


Map No. _____ Sec. 12 Twp. 22 R. 9Well No. 1 - Evans Farm
Basom et al Company990 Ft. from N. Line

_____ Ft. from S. Line

990 Ft. from E. Line

_____ Ft. from W. Line

NORTH

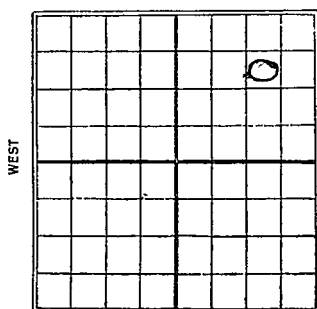

SOUTH

1927

Date

REPORT

9/28 Location10/610/12 Rigging up10/19 Drill 50010/27 " 1325'11/2 " 1900'11/9 Top line 2460Break 2503-20'D. & A. 2520 - H.F.W.

22 KANSAS

Map No. _____ Sec. 12 Twp. 22 R. 9

Well No. 1 Evans

Bosom at 4L

Company

Contractor

FIRST REPORTS

990 Ft. from N. Line

_____ Ft. from S. Line

990 Ft. from E. Line

_____ Ft. from W. Line

SECTION PLAT

			0

Location ✓ _____

Rig up _____

Drilling and Remarks:

RECORD

Cased _____ in., _____ ft.

Sand _____

Gas _____

Oil _____

Total Depth _____

PRODUCTION

1st 24 hrs. Nat. _____

1st 24 hrs. after shot _____

Gas _____ Cu. Ft.

Dry Hole _____

Abandoned _____

Date

SEP 28 1927

CHAS. L. SHERWOOD

192

Scout

22 ¹/₄ ANSAS 12 Sec. 12 Twp. 22 R. 9
 Map No. _____
 Well No. 1 Coburn
 _____ Company

Contractor _____

COMPLETED

SECTION PLAT

			0

990 Ft. from N. Line

_____ Ft. from S. Line

990 Ft. from E. Line

_____ Ft. from W. Line

ABANDONED

Location _____

Rig up _____

Drilling and Remarks:

Tap line 2460

Break 2503.20

2 1/4 2520
1 1/2 W

RECORD

Cased _____ in., _____ ft.

Sand _____

Gas _____

Oil _____

Total Depth 2520

PRODUCTION

1st 24 hrs. Nat. _____

1st 24 hrs. after shot _____

Gas _____ Cu. Ft.

Dry Hole ☒Abandoned ☒

Date

NOV 9 - 1927

CHAS. L. SHERWOOD

192

Scout