

Greenwood Co.

Map No. Kansas Sec. 12 Twp. 22 R. 10

Well No. 1 Austin Farm

White Eagle O+R-etal Company


NORTH

_____ Ft. from N. Line

990 Ft. from S. Line

330 Ft. from E. Line

_____ Ft. from W. Line

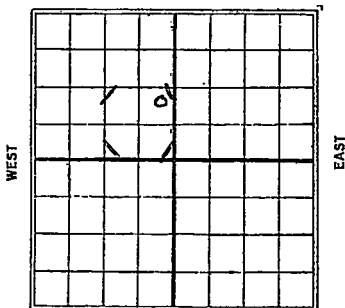

SOUTH

Date 1926

REPORT

<u>1/20</u>	<u>Rig up</u>
<u>1/29</u>	<u>Rigging up.</u>
<u>2/4</u>	<u>D. lg 950'</u>
<u>2/10</u>	<u>1700'</u>
<u>2/17</u>	<u>Top sand 2066-2154'</u> <u>T. D. 2158' in shale.</u> <u>filled up 400' oil 24</u> <u>hrs, will shoot 320 qts.</u>
<u>2/24</u>	<u>Shot 320 qts. Swabbing-</u> <u>same sand record.</u>
<u>3/5</u>	<u>_____</u>
<u>3/10</u>	<u>_____</u>
<u>3/18</u>	<u>Sand 2066-2154</u> <u>T. D. 2158 320 qts 200</u> <u>blb</u>

Sherwood Co

K21 **KANSAS** Sec. *12* Twp. *22* R. *10*

Well No. *1* **AUSTIN**

White Eagle Oil Co Company

Contractor

FIRST REPORTS

SECTION PLAT

----- Ft. from N. Line
996 Ft. from S. Line
330 Ft. from E. Line
 ----- Ft. from W. Line

	/	o	
	/	/	

Location -----
 Rig up -----
 Drilling and Remarks:

RECORD

Cased ----- in., ----- ft.
 Sand -----
 Gas -----
 Oil -----
 Total Depth -----

PRODUCTION

1st 24 hrs. Nat. -----
 1st 24 hrs. after shot -----
 Gas ----- Cu. Ft.
 Dry Hole -----
 Abandoned -----

Date

JAN 20 1926

CHAS. L. SHERWOOD
 Scout

Sherwood

1521 KANSAS Sec. 12 Twp. 22 R. 10

Well No. *1* *water*

White Eagle RR Company

Contractor

COMPLETED


SECTION PLAT

----- Ft. from N. Line

990 Ft. from S. Line

330 Ft. from E. Line

----- Ft. from W. Line

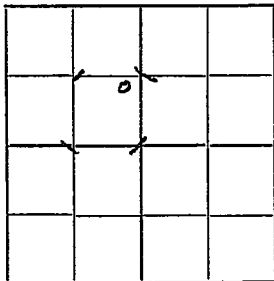

Location -----

Rig up -----

Drilling and Remarks:

3200 200 ss.

RECORD

Cased _____ in., _____ ft.

Sand *2066-2154'*

Gas -----

Oil -----

Total Depth *2158' sub*

PRODUCTION

1st 24 hrs. Nat. -----

1st 24 hrs. after shot. -----

Gas ----- Cu. Ft.

Dry Hole -----

Abandoned -----

Date

MAR 18 1926

CHAS. L. SHERWOOD

192

Scout