

*Greenwood*


Form 51-5M-3-26-22544

Map No. *Kand.* Sec. *12* Twp. *22* R. *10*

Well No. *3 - Auster* Farm

*White Eagle Etal* Company

NORTH

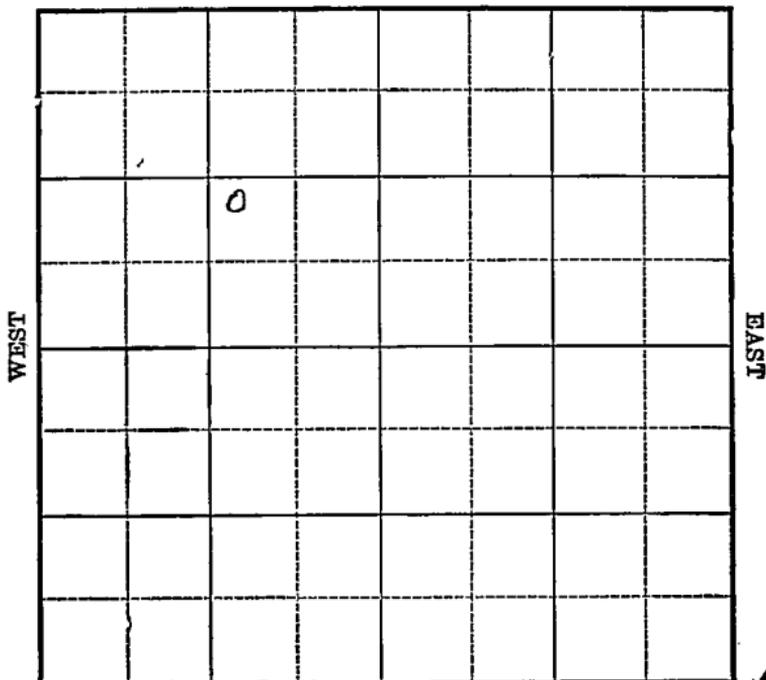

*6*

Location \_\_\_\_\_

Drilling Remarks \_\_\_\_\_

\_\_\_\_\_

\_\_\_\_\_

Rig Up \_\_\_\_\_

Drilling Remarks \_\_\_\_\_

\_\_\_\_\_

\_\_\_\_\_

**RECORD**

Cased \_\_\_\_\_ in. \_\_\_\_\_ ft.

Sand \_\_\_\_\_

Gas \_\_\_\_\_

Oil \_\_\_\_\_

Total Depth \_\_\_\_\_

**PRODUCTION**

1st 24 hrs. Nat. \_\_\_\_\_

1st 24 hrs. after shot \_\_\_\_\_

Gas \_\_\_\_\_ cu. ft.

Dry Hole \_\_\_\_\_

Abandoned \_\_\_\_\_



*Sherwood*

*K-21* KANSAS Sec. *12* Twp. *22* R. *10*

Well No. *3* *Austen*

*White Eagle Oil Co* Company

Contractor

**FIRST REPORTS**

**SECTION PLAT**

----- Ft. from N. Line

*990* Ft. from S. Line

*990* Ft. from E. Line

----- Ft. from W. Line

	<i>o</i>	<i>o</i>	
	<i>o</i>	<i>o</i>	

Location -----

Rig up ----- *Jumbos*

Drilling and Remarks:

**RECORD**

Cased ----- in., ----- ft.

Sand -----

Gas -----

Oil -----

Total Depth -----

**PRODUCTION**

1st 24 hrs. Nat. -----

1st 24 hrs. after shot -----

Gas ----- Cu. Ft.

Dry Hole -----

Abandoned -----

Date

APR 21 1926

192

**CHAS. L. SHERWOOD**

Scout

K21 KANSAS Sec. 12 Twp. 22 R. 10

Well No. 3 water

White Eagle Oil Company

Contractor

COMPLETED

SECTION PLAT

\_\_\_\_\_ Ft. from N. Line

990 Ft. from S. Line

990 Ft. from E. Line

\_\_\_\_\_ Ft. from W. Line

	0		

Location \_\_\_\_\_

Rig up \_\_\_\_\_

Drilling and Remarks:

249150 lbs.

RECORD

Cased \_\_\_\_\_ in., \_\_\_\_\_ ft.

Sand 2047-2131'

Gas \_\_\_\_\_

Oil \_\_\_\_\_

Total Depth 2137'

PRODUCTION

1st 24 hrs. Nat. \_\_\_\_\_

1st 24 hrs. after shot. \_\_\_\_\_

Gas \_\_\_\_\_ Cu. Ft.

Dry Hole \_\_\_\_\_

Abandoned \_\_\_\_\_

Date

MAY 19 1926

CHAS. L. SHERWOOD

192

Scout