


Map No. Page Sec. 12 Twp. 22 R. 10 #

Well No. J. Better Farm
Jim Davis et al. Company

330' Ft. from N. Line
 _____ Ft. from S. Line
330' Ft. from E. Line
 _____ Ft. from W. Line

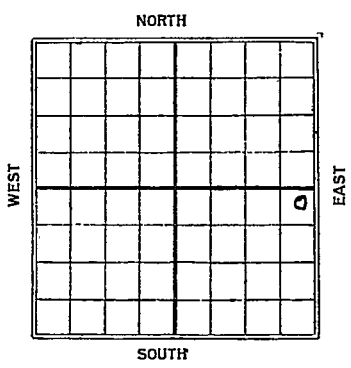

Date	REPORT
1925	
7/24	L.O.
7/31	Rig on Ground
8/7	_____
8/14	spud
8/19	spud
8/26	650'
9/13	1500
9/11	Top sand 2055-2057
	1st oil 2063 - 2075 - 2117'
	I.D. 2129 swabbed 150 Hb
9/19	Sand 2055-2129 240 gals
	715 Bbls

Map No. 21 N 1/2 Sec. 12 Twp. 22 R. 10

Well No. 8 Bither

Jim Davis & Co Company

Contractor

FIRST REPORTS

SECTION PLAT

330 Ft. from N. Line

_____ Ft. from S. Line

330 Ft. from E. Line

_____ Ft. from W. Line

			o

Location

Rig up _____

Drilling and Remarks:

/

RECORD

Cased _____ in., _____ ft.

Sand _____

Gas _____

Oil _____

Total Depth _____

PRODUCTION

1st 24 hrs. Nat. _____

1st 24 hrs. after shot _____

Gas _____ Cu. Ft.

Dry Hole _____

Abandoned _____

Date

JUL 24 1925

CHAS. L. SHERWOOD

192

Scout

Sherrwood Co

Map No. 21 KANSAS Sec. 12 Twp. 22 R. 10

Well No. 8 *Bitton*

Jim Davis Company

Contractor

COMPLETED

SECTION PLAT

330 Ft. from N. Line

_____ Ft. from S. Line

330 Ft. from E. Line

_____ Ft. from W. Line

			o

Location _____

Rig up _____

Drilling and Remarks:

1st oil 2063'

Pay 2085-2117'

240/715 bhs

RECORD

Cased _____ in., _____ ft.

Sand 2055-2129'

Gas _____

Oil _____

Total Depth 2129'

PRODUCTION

1st 24 hrs. Nat. _____

1st 24 hrs. after shot _____

Gas _____ Cu. Ft.

Dry Hole _____

Abandoned _____

Date

SEP 19 1925

CHAS. L. SHERWOOD

192

Scout