


Section 12 Township 22 Range 10 E

Well No. # S-6 D & S Unit (water supply)

Company Phillips Pet.

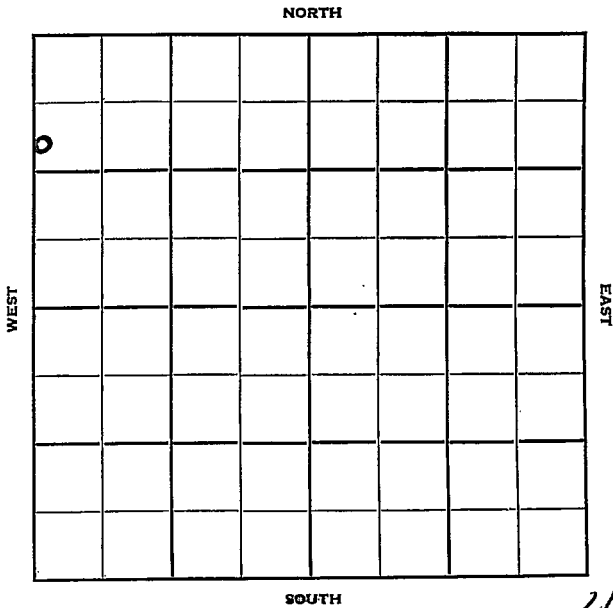

4

Greenwood 22

Sec. 12 Twp. 22 R. 10E

Well No. S-6 D & S Unit Farm

Phillips Pet. Company

Phillips - Contr. Contractor


1040' Ft. from N. Line

Ft. from S. Line

Ft. from E. Line

161' Ft. from W. Line

SW NW NW

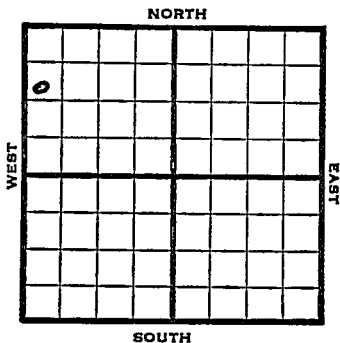

1952

Elev. 1229' REPORT

7/23

15" @ 147 Arb. Test

Lans. 1160

BKC 1560

Marm 1695

Drlg. 1735

8/13

Water supply well TD 3475

15" @ 147 Lans. 1160 BKC 1560

Marm 1695 Bart 2026 Bart Sd 2050

Miss 2159

Schlumberger Tops:

Lans. 1168 BKC 1563

Marm. 1692 Bart 2026

Bart Sd 2050 Miss 2158

Kh' 2550 Viola 2637

TD 2670 8" @ 2660 DD 2930

Simp 2697 Arb. 2730

Regan 3435 Weathered Gr 3439

Granite 3462 TD 3475

Comp. for wtr supply

ABANDONED

County Greenwood State Kansas

Sec. 12 (Blk. 22) (Sur. 10E) (Twp. 22) (Rge. 10E) Map No.

Operator Phillips Pet.

Well No. S-6 Farm D & S Unit (water supply)

Elev. _____ Location SW NW NW

D					

FIRST REPORT

1040 Ft. From N Line NW

161 Ft. From W Line Quarter

Ist. Report JUL 23 1952

Completion _____

Remarks Arb. test

Phillips - Contr.

Spudding Date _____

Drlg. Data _____

15" @ 147 Lans. 1160 B KC 1560

Marm. 1695 drlg. 1735

J. G. McGEHEE

