
Form 51—5M—7-25—19786

Map No. Kansas Sec. 12 Twp. 22 R. 10

Well No. 11 De Malorie Farm

Davis et al Company

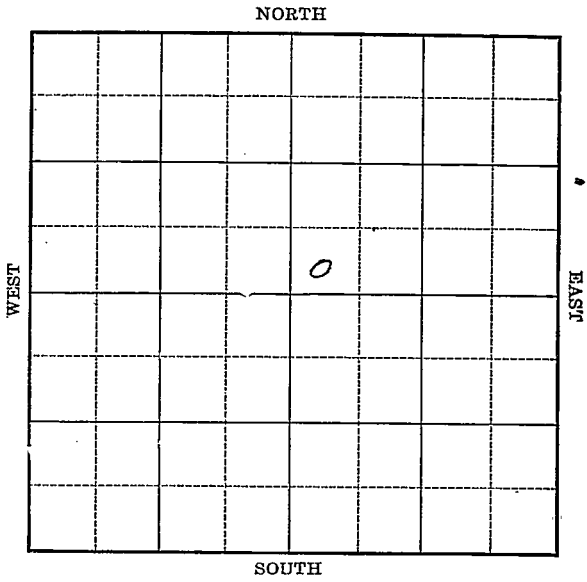

7

Location _____

Drilling Remarks

Rig Up _____

Drilling Remarks

RECORD

Cased _____ in. _____ ft.

Sand _____

Gas _____

Oil _____

Total Depth _____

PRODUCTION

1st 24 hrs. Nat. _____

1st 24 hrs. after shot _____

Gas _____ cu. ft.

Dry Hole _____

Abandoned _____

Form 252A—5M—7-25—19684

Kansas / Greenwood Co.


Map No. / Sec. 12 Twp. 22 R. 10

Well No. 11 De Malorie Farm

Davis et al Company

330 Ft. from S. Line

330 Ft. from W. Line

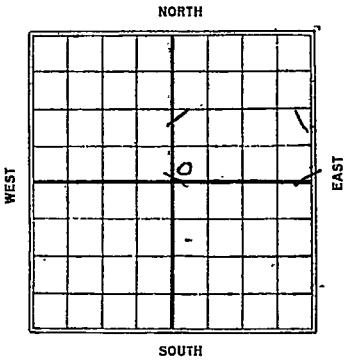

Date 1926	REPORT
1/20	Rig up
1/21	"
2/4	Rigging up.
2/10	Dlg 700'
2/17	" 1525'
2/24	Top sand 2044' oil 2079' T.D 2119' in sd. Swabd. 35 bbls nat. Will shoot.
3/5	Shot 320 qts. Swab 20 BBls. Per hour.
3/11	Sand 2044-2119 320 qts 600 bbls

Form 26—1M Bks.—3-23—11959. Sherwood Co

K21

Map No. KANSAS Sec. 12 Twp. 22 R. 10

Well No. 11 De Malotte

Davis et al Company

Contractor

FIRST REPORTS


Ft. from N. Line

330 Ft. from S. Line

Ft. from E. Line

330 Ft. from W. Line

SECTION PLAT

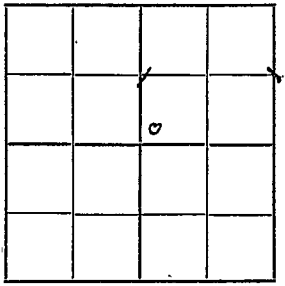

Location

Rig up ✓

Drilling and Remarks:

RECORD

Cased in., ft.

Sand

Gas

Oil

Total Depth

PRODUCTION

1st 24 hrs. Nat.

1st 24 hrs. after shot

Gas Cu. Ft.

Dry Hole

Abandoned

Date

JAN 20 1926 192

CHAS. L. SHERWOOD Scout

Form 26—1M Blks.—3-23—11959. Greenwood

K21 Map No. KANSAS Sec. 12 Twp. 22 R. 10

Well No. 11 Demaris

Davis et al Company

Contractor

COMPLETED


Ft. from N. Line

330 Ft. from S. Line

Ft. from E. Line

330 Ft. from W. Line

SECTION PLAT

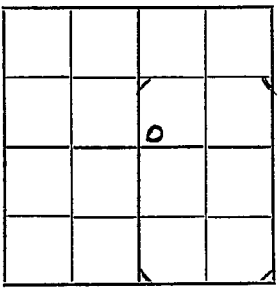

Location

Rig up

Drilling and Remarks:

1st oil 2079'.
320 600 bbls

RECORD

Cased in., ft.

Sand 2044-2119

Gas

Oil

Total Depth 2119

PRODUCTION

1st 24 hrs. Nat.

1st 24 hrs. after shot

Gas Cu. Ft.

Dry Hole

Abandoned

Date

MAR 11 1926 CHAS. L. SHERWOOD

192 Scout