
Form 51—5M—7-25—19786 Kansas - Greenwood Co

Map No. [illegible] Sec. 12 Twp. 22 R. 10

Well No. 14 De Maloie Farm

Davis et al Company

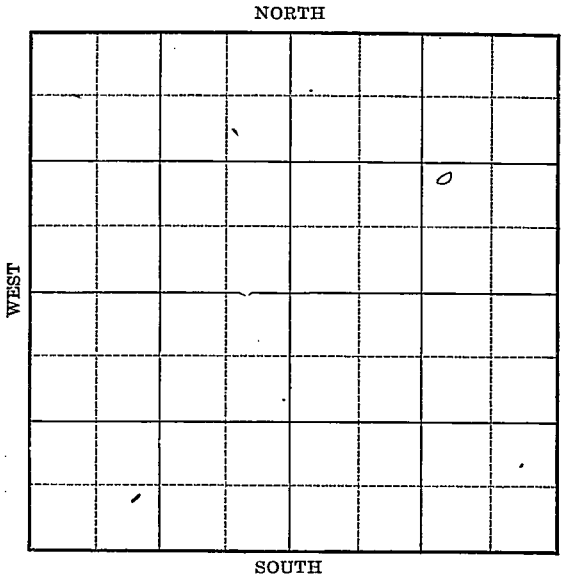

8

Location

Drilling Remarks

Rig Up

Drilling Remarks

RECORD

Cased in. ft.

Sand

Gas

Oil

Total Depth

PRODUCTION

1st 24 hrs. Nat.

1st 24 hrs. after shot

Gas cu. ft.

Dry Hole


Abandoned

Form 252A—5M—7-25—19684 Greenwood

Map No. Kansas Sec. 12 Twp. 22 R. 10

Well No. 14 De Malorie Farm

Davies etal Company

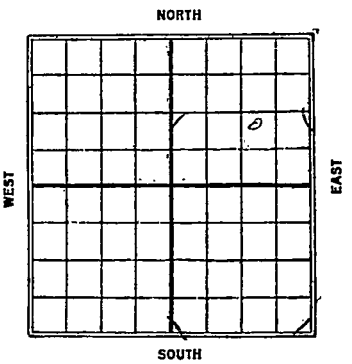

_____ Ft. from N. Line

990 Ft. from S. Line

990 Ft. from E. Line

_____ Ft. from W. Line

Date 1926	REPORT
3/18	Rigging up
3/25	Dlg 1000
4/1	" 1500
4/7	Sand 2001–2054
	T.D. 2074 140 gte 250 bbls

Form 26—1M Bks.—3-23—11959. S Sherwood

1021 Map No. KANSAS Sec. 12 Twp. 22 R. 10


Well No. 14 DeMaloke

Davis Oil Company

Contractor

FIRST REPORTS

SECTION PLAT

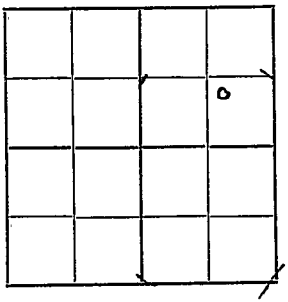

_____Ft. from N. Line

990 Ft. from S. Line

990 Ft. from E. Line

_____Ft. from W. Line

Location _____

Rig up _____

Drilling and Remarks:

Rigging up

RECORD

Cased _____ in., _____ ft.

Sand _____

Gas _____

Oil _____

Total Depth _____

PRODUCTION

1st 24 hrs. Nat. _____

1st 24 hrs. after shot _____

Gas _____ Cu. Ft.

Dry Hole _____

Abandoned _____

Date

MAR 18 1926 192____

CHAS. L. SHERWOOD Scout

Form 26—1M Bks.—3-23—11959. S Kingwood


K21 KANSAS Map No. Sec. 12 Twp. 22 R. 10

Well No. 1x De Maloris

Davis & Ad Company

Contractor

SECTION PLAT

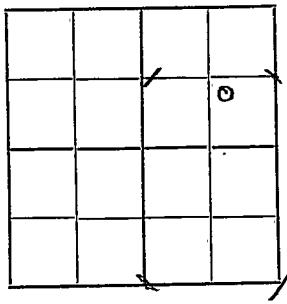

Ft. from N. Line

990 Ft. from S. Line

990 Ft. from E. Line

Ft. from W. Line

COMPLETED

Location

Rig up

Drilling and Remarks:

1404 250 lbs.

RECORD

Cased in., ft.

Sand 2001- 2054'

Gas

Oil

Total Depth 2074'

PRODUCTION

1st 24 hrs. Nat.

1st 24 hrs. after shot

Gas Cu. Ft.

Dry Hole

Abandoned

Date

APR 7 1926

192

CHAS. L. SHERWOOD Scout