


Map No. Kansas Sec. 12 Twp. 22 R. 10V

Well No. 18 De Malorie Farm

Sams et al Company

NORTH

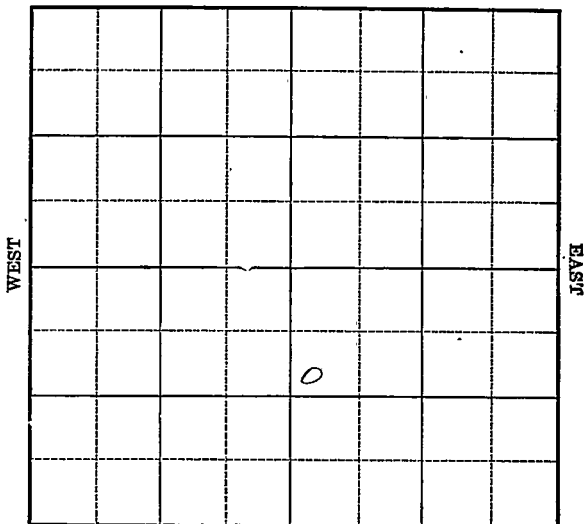

SOUTH

10

Location _____

Drilling Remarks _____

Rig Up _____

Drilling Remarks _____

RECORD

Cased _____ in. _____ ft.

Sand _____

Gas _____

Oil _____

Total Depth _____

PRODUCTION

1st 24 hrs. Nat. _____

1st 24 hrs. after shot _____

Gas _____ cu. ft.

Dry Hole _____

Abandoned _____

Shenwood

Map No. **K21 KANSAS** Sec. *12* Twp. *22* R. *10*

Well No. *18 De Malorio*

Davis et al Company

Contractor

FIRST REPORTS

SECTION PLAT

990 Ft. from N. Line

----- Ft. from S. Line

----- Ft. from E. Line

330 Ft. from W. Line

		o	

Location -----

Rig up -----

Drilling and Remarks:

Ro 4

RECORD

Cased ----- in., ----- ft.

Sand -----

Gas -----

Oil -----

Total Depth -----

PRODUCTION

1st 24 hrs. Nat. -----

1st 24 hrs. after shot -----

Gas ----- Cu. Ft.

Dry Hole -----

Abandoned -----

Date

MAY 12 1926

192

CHAS. L. SHERWOOD
Scout

Greenwood

Map No. *K21 KANSAS* Sec. *12* Twp. *22* R. *10*

Well No. *18 De Melodie*

Davis et al Company

Contractor

COMPLETED


SECTION PLAT

990 Ft. from N. Line

----- Ft. from S. Line

----- Ft. from E. Line

530 Ft. from W. Line

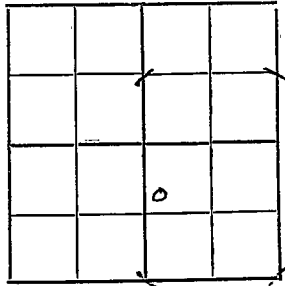

Location -----

Rig up -----

Drilling and Remarks:

Shale 2071-98'
top line 2198'
Plugged back to
2176' 2207 150 fl.

RECORD

Cased _____ in., _____ ft.

Sand *2067-2169'*

Gas -----

Oil -----

Total Depth *2198'*

PRODUCTION

1st 24 hrs. Nat. -----

1st 24 hrs. after shot -----

Gas ----- Cu. Ft.

Dry Hole -----

Abandoned -----

Date

JUN 24 1926

CHAS. L. SHERWOOD