


Greenwood

Map No. *12N* Sec. *12* Twp. *22* R. *10*

Well No. *23 - Demalorie* Farm
Harris et al Company

NORTH

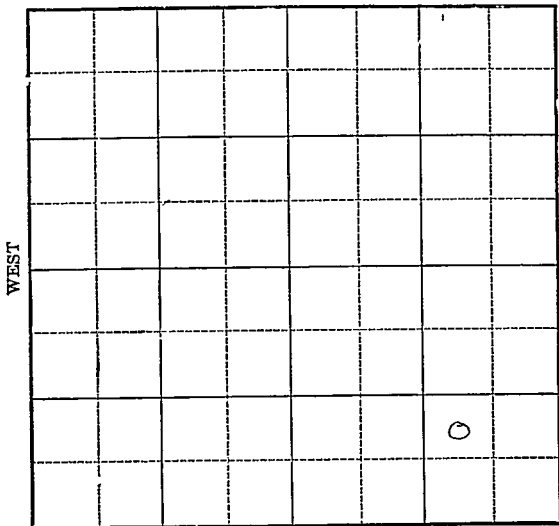

SOUTH

16

Location _____

Drilling Remarks _____

Rig Up _____

Drilling Remarks _____

RECORD

Cased _____ in. _____ ft.

Sand _____

Gas _____

Oil _____

Total Depth _____

PRODUCTION

1st 24 hrs. Nat. _____

1st 24 hrs. after shot _____

Gas _____ cu. ft.

Dry Hole _____

Abandoned _____

Greenwood

Map No. *17AN* Sec. *12* Twp. *22* R. *10*


Well No. *23* *Demaloric* Farm
Davis et al. Company

_____ Ft. from N. Line

990 Ft. from S. Line

990 Ft. from E. Line

_____ Ft. from W. Line

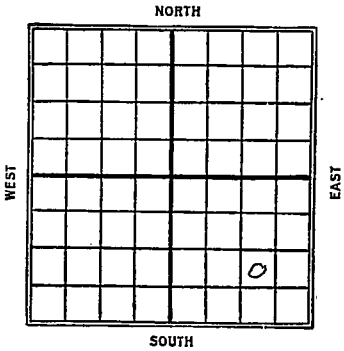

1926

Date

REPORT

<i>8/11</i>	<i>Location</i>
<i>8/18</i>	<i>—</i>
<i>8/25</i>	<i>same</i>
<i>8-31</i>	<i>—</i>
<i>9/16</i>	<i>rigging up</i>
<i>9/22</i>	<i>Dr lg 15-40</i>
<i>9/29</i>	<i>" 13-15</i>
<i>10/13</i>	<i>Sand 2066-2140</i>
	<i>P.B. to 2152'</i>
	<i>240/100 bbls</i>

Sherwood

Map No. K21 KANSAS Sec. 12 Twp. 22 R. 10

Well No. 23 de Malotie

Davis at #h

Company _____

Contractor _____

FIRST REPORTS

SECTION PLAT

			o

_____ Ft. from N. Line

990 Ft. from S. Line

990 Ft. from E. Line

_____ Ft. from W. Line

Location _____
 Rig up _____
 Drilling and Remarks: _____

RECORD

Cased _____ in., _____ ft.
 Sand _____
 Gas _____
 Oil _____
 Total Depth _____

PRODUCTION

1st 24 hrs. Nat. _____
 1st 24 hrs. after shot _____
 Gas _____ Cu. Ft.
 Dry Hole _____
 Abandoned _____

Date

AUG 11 1926

192

CHAS. L. SHERWOOD

Scout

Brimwood

21 KANSAS

Map No. _____ Sec. *12* Twp. *22* R. *10*

Well No. *23 DeMalotie* Farm _____

Davis et Ah Company

NORTH

		COMPLETED				

990
x
990

WEST

EAST

SOUTH

Location _____

Rig up _____

Drilling and Remarks:

Slugged back to

2152

2407 100 lbs.

RECORD

Cased _____ in., _____ ft.

Sand *2066-2140*

Gas _____

Oil _____

Total Depth *2162*

PRODUCTION

1st 24 hrs. Nat. _____

1st 24 hrs. after shot _____

Gas _____ Cu. Ft.

Dry Hole _____

Abandoned _____

Date OCT 13 1926

CHAS. L. SHERWOOD

Scout