


Map No. Kansas Sec. 12 Twp. 22 R. 10Well No. 22 Hemalorie-Lauden FarmDavis et al Company

NORTH

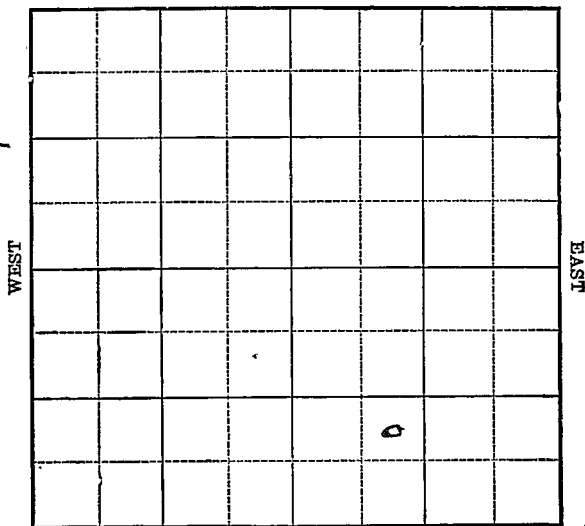

SOUTH

15

Location _____

Drilling Remarks _____

Rig Up _____

Drilling Remarks _____

RECORD

Cased _____ in. _____ ft.

Sand _____

Gas _____

Oil _____

Total Depth _____

PRODUCTION

1st 24 hrs. Nat. _____

1st 24 hrs. after shot _____

Gas _____ cu. ft.

Dry Hole _____

Abandoned _____

Greenwood

Map No. 17 Sec. 12 Twp. 22 R. 18Well No. 22 DeMalorie FarmDavis et al Company


Ft. from N. Line

990 Ft. from S. Line

Ft. from E. Line

990 Ft. from W. Line

NORTH

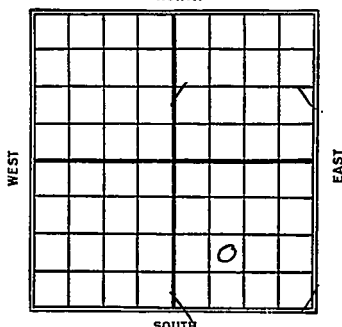

SOUTH

1926

Date

REPORT

7/21 Location

7/28 timbers

8/4 Rig

8/11 Dlg 375-

8/18 " 1400

8/25 Ddlg 2000

9/1 Sand 2238-2256

Top line 2280, T.D. 2280

80/10 bbls

K21 KANSAS

Map No. _____ Sec. 12 Twp. 22 R. 10

Well No. 22 De Muldoon - Jones

Davis et al _____ Company

_____ Contractor

FIRST REPORT


SECTION PLAT

_____ Ft. from N. Line

990 _____ Ft. from S. Line

_____ Ft. from E. Line

990 _____ Ft. from W. Line

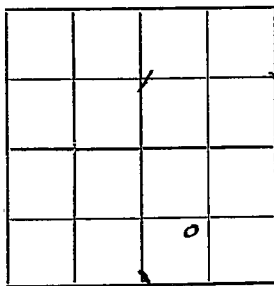

Location ✓ _____

Rig up _____

Drilling and Remarks:

RECORD

Cased _____ in., _____ ft.

Sand _____

Gas _____

Oil _____

Total Depth _____

PRODUCTION

1st 24 hrs. Nat. _____

1st 24 hrs. after shot _____

Gas _____ Cu. Ft.

Dry Hole _____

Abandoned _____

Date

JUL 21 1926

CHAS. L. SHERWOOD

192

Scout

Sherwood

Map No. 21 KANSAS Sec. 12 Twp. 22 R. 10
 Well No. 22 De Meloria
Davis et al Company

Contractor

COMPLETED

SECTION PLAT

Ft. from N. Line
990
 Ft. from S. Line
 Ft. from E. Line
990
 Ft. from W. Line

		6	

Location

Rig up

Drilling and Remarks:

Top line 2280

8 1/10 lbs.

RECORD

Cased _____ in., _____ ft.
 Sand 2238-2256
 Gas _____
 Oil _____
 Total Depth 2280

PRODUCTION

1st 24 hrs. Nat. _____
 1st 24 hrs. after shot _____
 Gas _____ Cu. Ft.
 Dry Hole _____
 Abandoned _____

Date

SEP 1 1926

CHAS. L. SHERWOOD

Scout