


Map No. 15 Sec. 13 Twp. 22 R. 10 ✓
 Well No. 21 De Malorie-Sanders
Davis et al. Company

NORTH

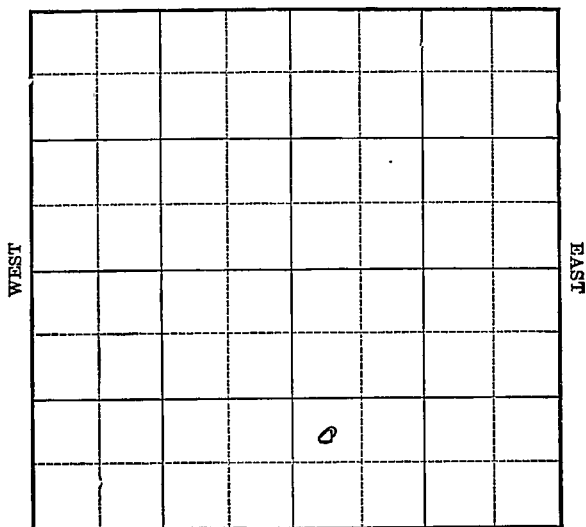

SOUTH

15

Location _____
 Drilling Remarks _____

Rig Up _____
 Drilling Remarks _____

RECORD

Cased _____ in. _____ ft.
 Sand _____
 Gas _____
 Oil _____
 Total Depth _____

PRODUCTION

1st 24 hrs. Nat. _____
 1st 24 hrs. after shot _____
 Gas _____ cu. ft.
 Dry Hole _____
 Abandoned _____

Greenwood

Map No. TRANS Sec. 12 Twp. 22 R. 10

Well No. 21 De Molozie Farm

Davis et al Company


-----Ft. from N. Line

990 Ft. from S. Line

Ft. from E. Line

330 Ft. from W. Line

1926

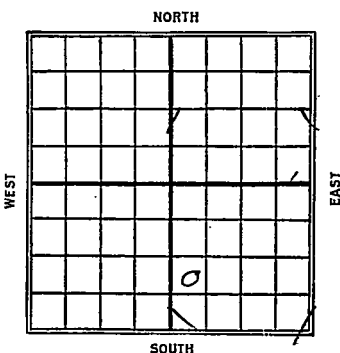

Date _____

REPORT

7/21	Rig up
7/28	Dlg 280'
8/4	" 1210
8/11	" 1850
8/18	Broken sand 2091-2101 top line 2215'
	Dlg 2400
8/25	Dlg 2575'
9/1	Bkn sd. 2091-2101 Top line 2215'
	D. & D. 2692 - J.D.

K21 KANSAS

Map No. _____ Sec. 12 Twp. 22 R. 10

Well No. 21 De Molle - Jansen

Davis et al _____ Company

_____ Contractor

FIRST REPORTS


_____ Ft. from N. Line

990 _____ Ft. from S. Line

_____ Ft. from E. Line

330 _____ Ft. from W. Line

SECTION PLAT

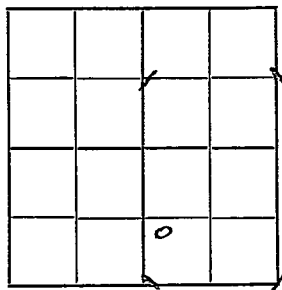

Location _____ ✓

Rig up _____

Drilling and Remarks:

RECORD

Cased _____ in., _____ ft.

Sand _____

Gas _____

Oil _____

Total Depth _____

PRODUCTION

1st 24 hrs. Nat. _____

1st 24 hrs. after shot _____

Gas _____ Cu. Ft.

Dry Hole _____

Abandoned _____

Date

JUL 21 1926

192

CHAS. L. SHERWOOD

Scout

21 **KANSAS** 12 **Folsomwood** 22 R. 10
Map No. Sec. Twp. R.
Well No. 21 **De Mulo Rio**
Davis Qt 4h

Company

Contractor

COMPLETED

SECTION PLAT

990 Ft. from N. Line
Ft. from S. Line
330 Ft. from E. Line
Ft. from W. Line

.			
			.
		o	

ABANDONED

Location

Rig up

Drilling and Remarks:

*Drilling 80 2091-2101
top line 2215'
DGS 2692'*

RECORD

Cased in, ft.
Sand
Gas
Oil
Total Depth *2692'*

PRODUCTION

1st 24 hrs. Nat.
1st 24 hrs. after shot
Gas Cu. Ft.
Dry Hole ✓
Abandoned ✓

Date

SEP 1 1926

CHAS. L. SHERWOOD

192

Scout