

Greenwood

KANSAS

SECTION 12 TOWNSHIP 22 RANGE 10E

WELL NO. #1 Kipfer "B"

COMPANY Keith Snyder

NORTH

WEST

EAST

							0

SOUTH

8

SEC.	TWP.	R.
12	22	10E

WELL NO.

#1 Kipfer "B"

FARM

COMPANY

Keith Snyder

CONTRACTOR

Jackman & Jackman

DeMalorie-Sowder

1070 Ft. from N. Line


Ft. from S. Line

250 Ft. from E. Line

Ft. from W. Line

SE SE NE

NE

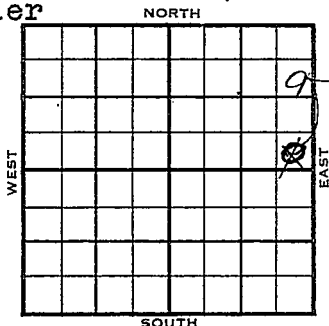

##1956

ELEVATION

REPORT

5-9

RUR

7-3

Comm. 5-10-56

8 5/8" @ 85

5 1/2" @ 2129

CO to 2120

~~5 1/2" @ 2129~~

CO 2134

Est. P/ 10 BOPD / 15 BWPD.

Bartl. Sd. 2128'

TD 2140'

COMPLETED

7-18

Was completed 10 bopd;

Now pumping 27 bopd;

COMPLETED

County Greenwood Elev. _____
 Sec. 12 Twp. 22 Rge. 10E
 Company Keith Snyder
 Farm Name Kipfer "B" No. 1

TOPS	DEPTH	LOG	DATUM	Loc. in Sec.
Anh.				SE SE NE
TP.				
H.				
Tr.				
Dg.				
Bl.				
L.				Geol. _____
K.C.				Contr. _____
B.K.C.				Jackman &
Ce.				Jackman
C.				Pool
M.				DeMalorie-
M.				Sowder
K.				
Mz.				
Me.				
V.				
S.				
S.				
A.				
R.				
Pe.				
G.				
T.D.				

FIRST REPORT
 MAY 9 1956

Date Comm.

R U R

ONE - 12 VARS
 ONE - 1 VARS

County Greenwood Elev. _____
 Sec. 12 Twp. 22 Rge. 10E
 Company Keith Snyder
 Farm Name Kipfer "B" No. 1

TOPS	DEPTH	LOG	DATUM	Loc. in Sec.
Anb.				SE SE NE
Tp.				
H. <u>Barthsd.</u>	<u>2128</u>			
Tr.				
Dg.				
Bl.				
L.				Geol. _____
K.C.				Contr. _____
B.K.C.				Jackman &
Ce.				Jackman
C.				Pool
M.				DeMalorie-
M.				Sowder
K.				
Mz.				
Mo.				
V.				
S.				
S.				
A.				
R.				
Pe.				
G.				
T.D.	<u>2140</u>			

Date Comm. JUL 3 1956

RUR MAY 15 '56 5-10-56 85/8 85

5 1/2 @ 2129 MAY 23 '56 MAY 29 '56 WOCT

JUN 6 '56 CO TO 2128 Free & Lot &

fishy JUN 13 '56 Paul JUN 20 '56 JUN 27 '56 JUL 3 '56

CO 2134 POP To P. Ld.

est P. 10 BOPd + 15 BWPd.

CORRECTION

FORM 513 SUNRAY

County Greenwood Elev. _____
 Sec. 13 Twp. 22N Rge. 10E
 Company Keith Snyder
 Farm Name Kinfer "B" No. 1

TOPS	DEPTH	LOG	DATUM	Loc. in Sec.
Anb.				SE NE NE
Tr.				1070' NL
Dg.				2 50' EL
Bl.				
L.				Geol.
K.C.				Contr.
B.K.C.				
Ce.				
C.				
M.				Pool
M.				
K.				
Mz.				
Mq.				
V.				
S.				
S.				
A.				
R.				
Pe.				
G.				
T.D.				

CORRECTION

Date Comm. JUL 18 '56

Comp. SE SE NE 12-22S-10E

Comp. 10 bopd Now pumping 27 bopd

100% 100% 100%

100%